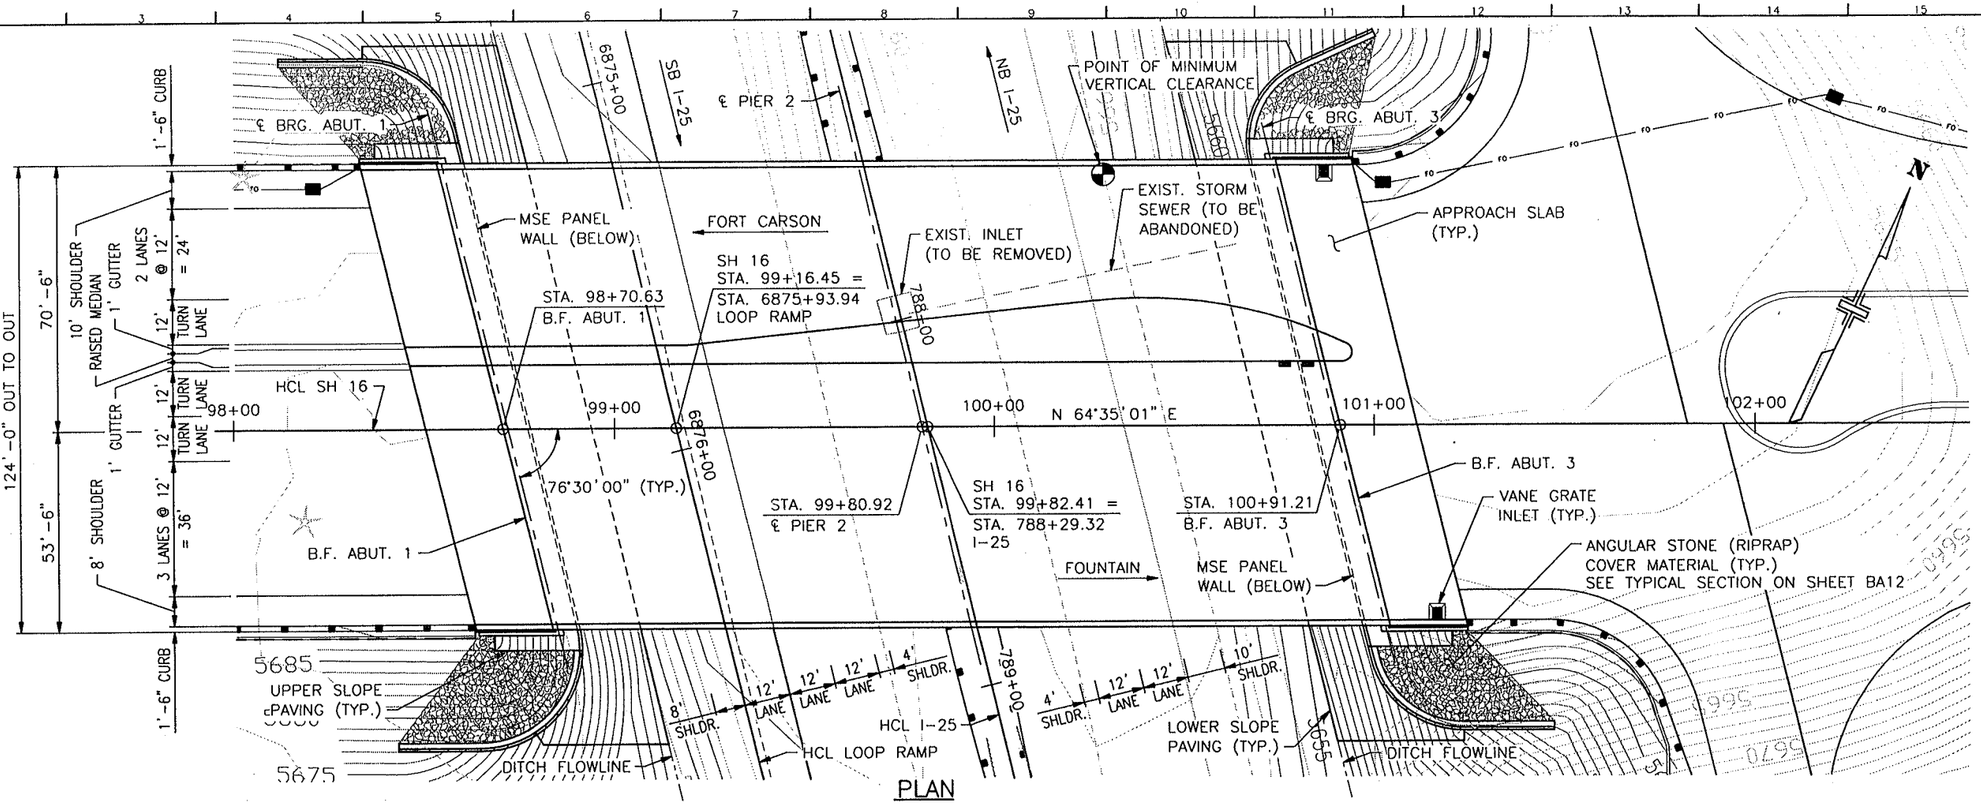

PLAN

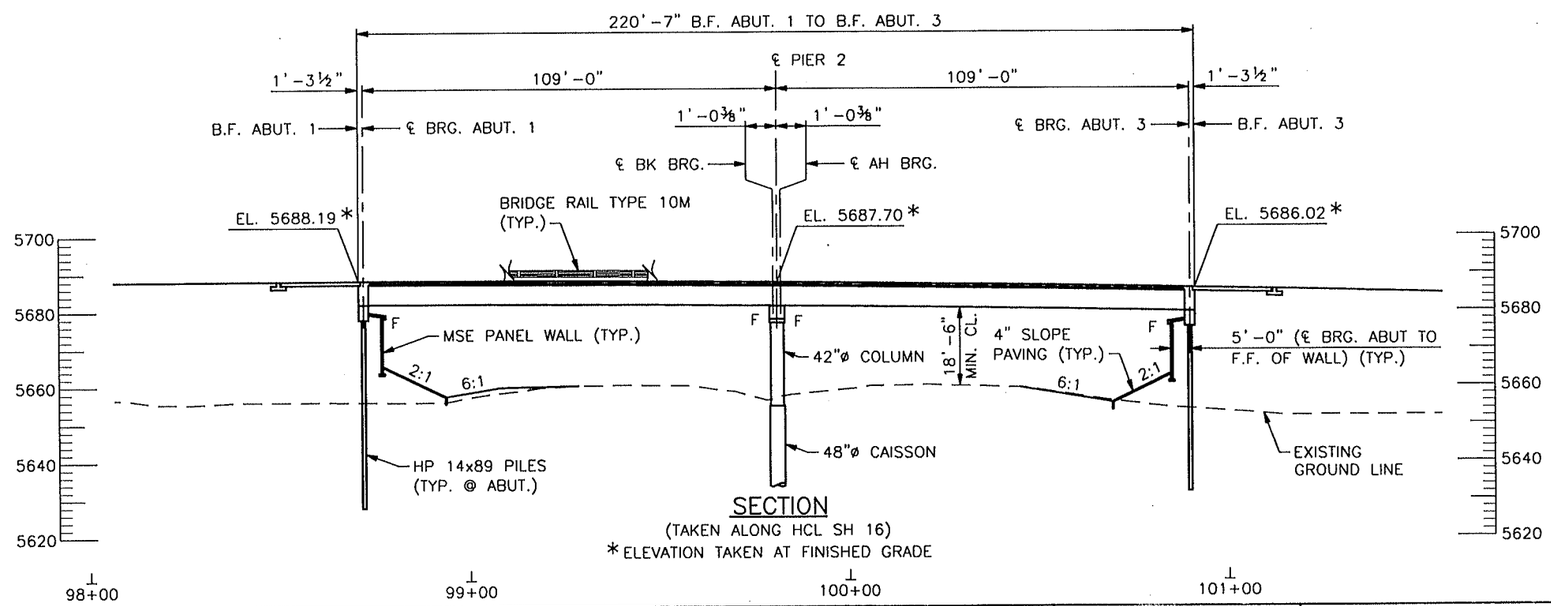

SECTION

(TAKEN ALONG HCL SH 16)

* ELEVATION TAKEN AT FINISHED GRADE

98+00 99+00 100+00 101+00

Design	INITIAL	DATE	Detail	INITIAL	DATE	Revision Dates (Preliminary Stage Only)	INITIAL	DATE
Designed By	PE	4/07	Detailed By	BDC	4/07	Quantities By	AB	4/07
Checked By	AB	4/07	Checked By	AB	4/07	Checked By	JMD	4/07

Computer File Information		Sheet Revisions	Colorado Department of Transportation	Carter::Burgess	As Constructed	SH 16 OVER I-25 GENERAL LAYOUT	Project No./Code
Creation Date:	Initials:		1480 Quail Lake Loop, Colorado Springs, CO 80906, Phone: 719-634-2323, Fax: 719-632-2172	707 17th Street, Suite 2300, Denver, Colorado 80202, Phone: 303-820-5240, Fax: 303-820-2402	No Revisions:		STU R200-110
Last Modification Date: 11/01/07	Initials:				Revised:	Designer: P. ENCINIAS; Structure Numbers: J-18-BM	13590
Full Path: J:_Transportation\070672.400\TO #4\cad\str\					Void:	Detailer: B. COLLINS	
Drawing File Name: 16I25GNL1.dwg						Sheet Subset: BRIDGE; Subset Sheets: BA4 of BA43	Sheet Number 204
Acad Ver. 16.1s	Scale: 1" = 40' Units:		Region 2 DMW				