F-16-EF

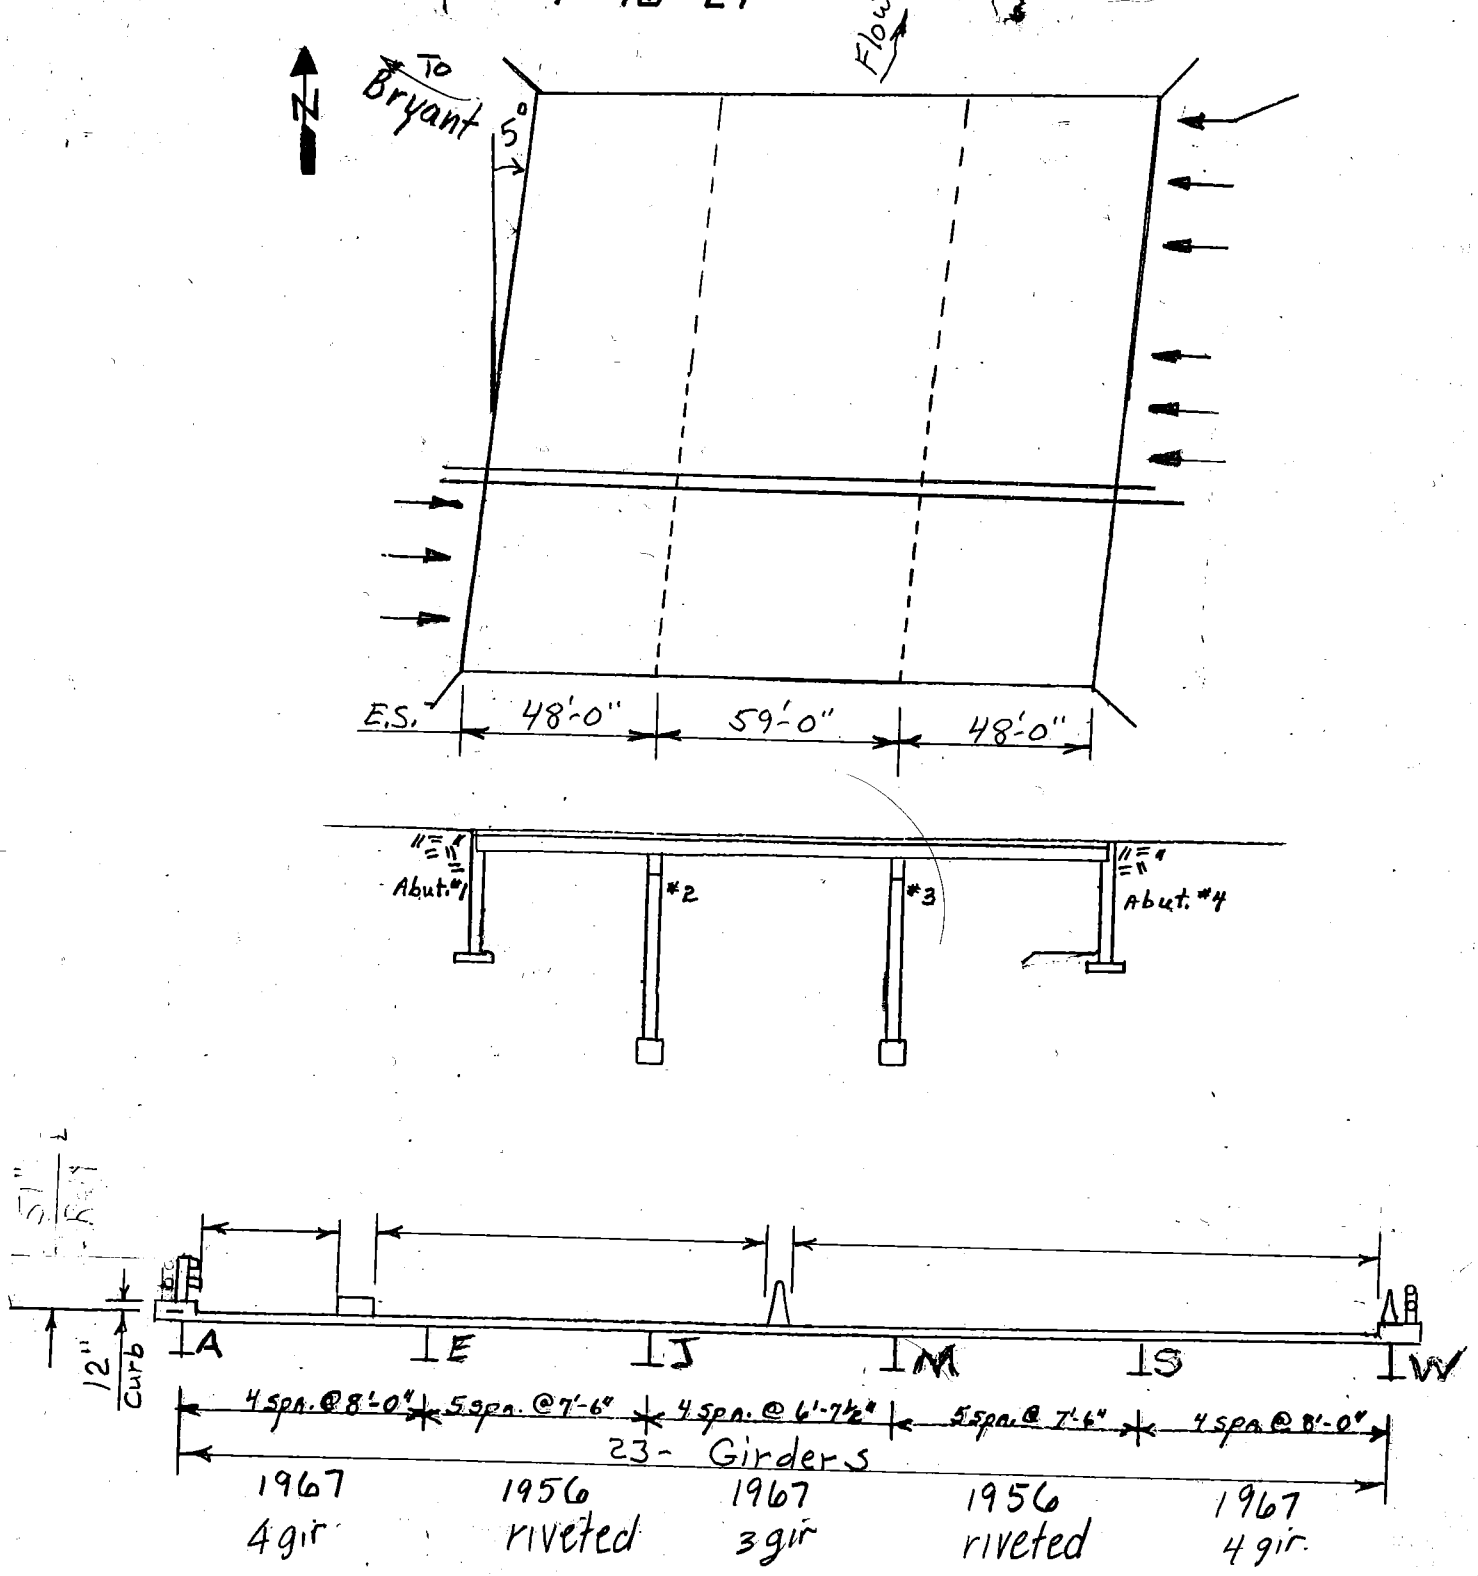
N
To Bryant
5°
Flow
E.S.
48'-0"
59'-0"
48'-0"
Abut. #1
#2
#3
Abut. #4
12"
Curb
A
E
J
M
S
W
4 spn. @ 8'-0"
5 spn. @ 7'-6"
4 spn. @ 6'-7½"
5 spn. @ 7'-6"
4 spn. @ 8'-0"
23 - Girders
1967
4 gir
1956
riveted
1967
3 gir
1956
riveted
1967
4 gir.