


# STATE OF COLORADO

DEPARTMENT OF TRANSPORTATION  
Region 6 Utilities Unit  
2000 South Holly Street  
Denver, Colorado 80222  
(303) 757-9910

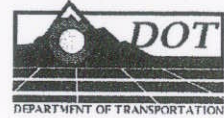

## Utility Information Sheet (UIS)

PE Project No.: STA 1281-011; WBS #: 15782  
CN Project No.: ~~STU 1281-012~~; WBS #: 16501  
*STA C800-001*

**Project Description: 120<sup>th</sup> Avenue Connection- Phase I**  
Construct new 120<sup>th</sup> Avenue Connection alignment from Wadsworth Pkwy (SH 121) to Old Wadsworth Blvd. Construct new Commerce Street from Park Street to 118<sup>th</sup> Avenue. Also, minor realignment of Old Wadsworth Blvd.

**UIS #:** 03-007  
**Utility Company:** City and County of Broomfield (Public)

**Work Performed by:** Contractor

**Location:** Commerce St Sta. 100+00

**Existing Utility:** Fire Hydrant


**Expected Impact:** Reset the existing fire hydrant to the west side of the proposed roadway at existing 120<sup>th</sup> Ave. and proposed Commerce Street.

**Attached:** Plan Sheet

CDOT Representative: *Ron Dickey* *7-3-2008*  
Ron Dickey – Region 6 Utility Manager Date

Utility Representative: *BK* *7/2/08*  
(Print name): *Burt Knight* Date

naszkowski 2:23:01 PM j:\transportation\072208.405\15782\utilities\drawings\15782\utilities03.dgn

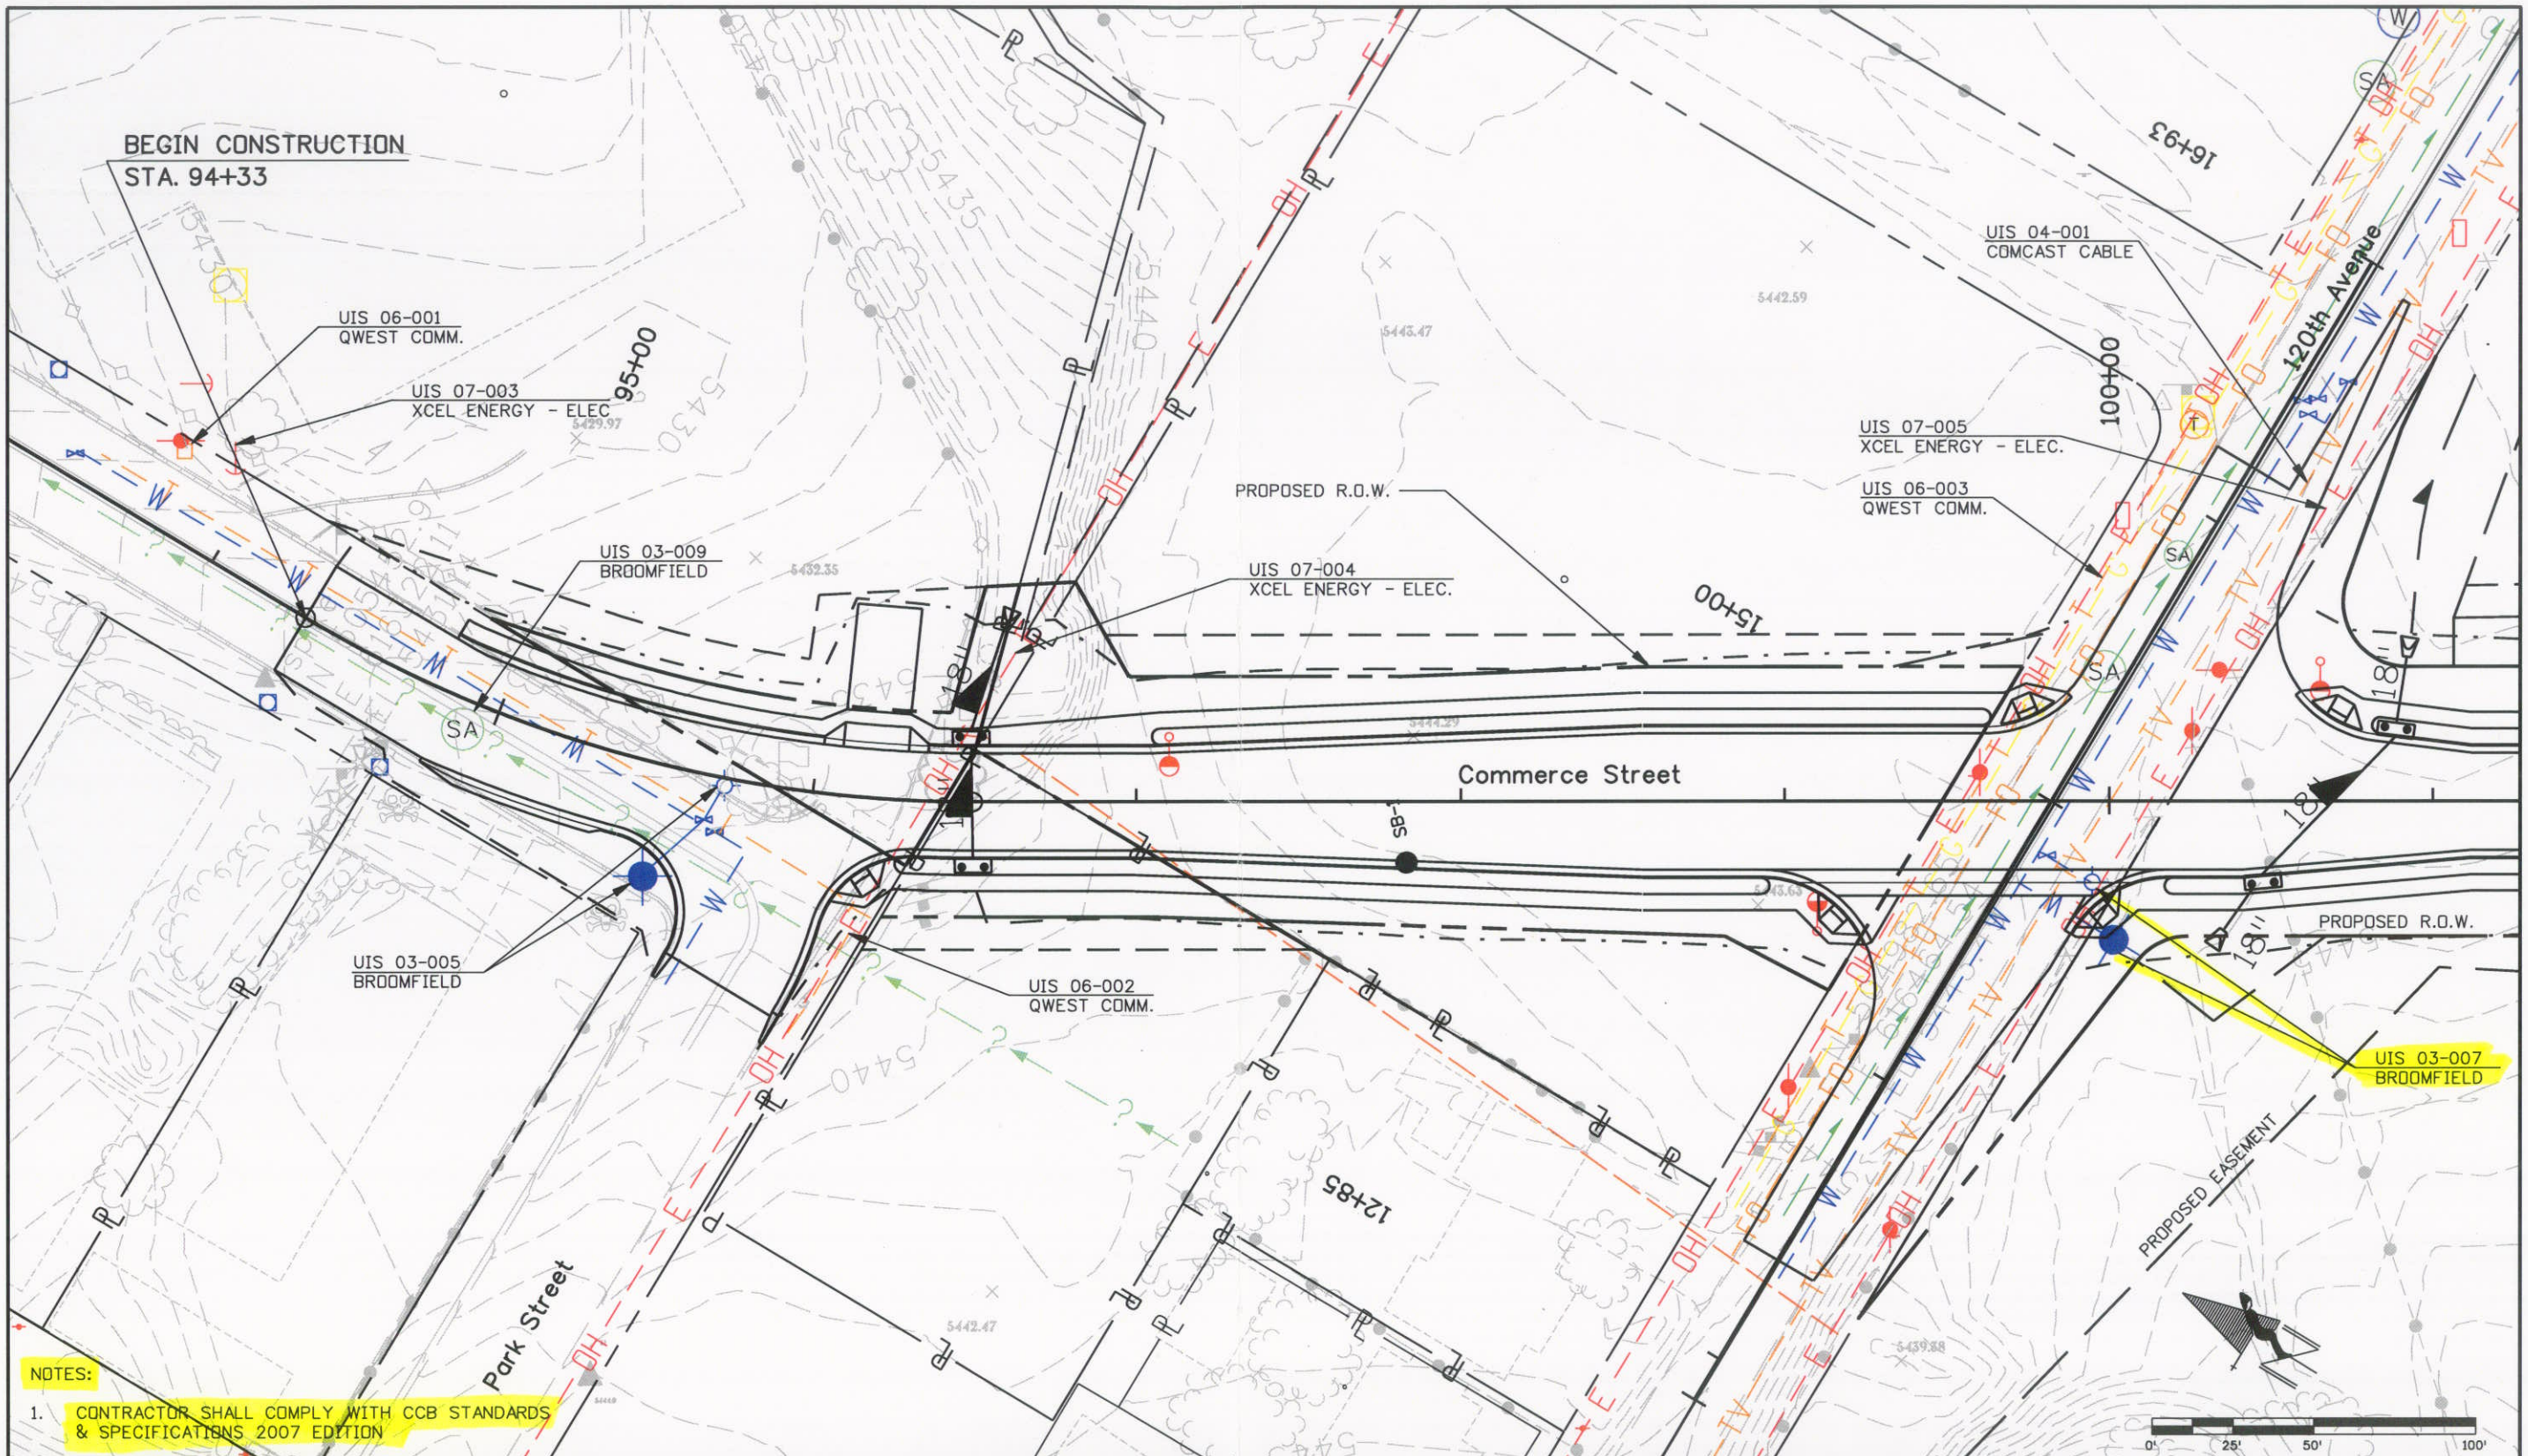

**NOTES:**

1. CONTRACTOR SHALL COMPLY WITH CCB STANDARDS & SPECIFICATIONS 2007 EDITION

Print Date: 5/5/2008	<b>Sheet Revisions</b>			<b>Colorado Department of Transportation</b>		<b>As Constructed</b>		<b>COMMERCE STREET UTILITIES</b>		<b>Project No./Code</b>			
File Name: 15782Utilities03.dgn	Date:	Comments	Init.	 4670 Holly Street Denver, CO 80216-6408 Phone: 303-398-6765 FAX: 303-398-6781		No Revisions:		Designer: XXXXXXXX Structure X-XX-XX Detailer: XXXXXXXX Numbers X-XX-XX Sheet Subset: UT Subset Sheets: 03 of 10		STA 1281-011			
Horiz. Scale: 1:50	Unit Information					Region 6				Revised:		16501	
Vert. Scale: As Noted	Unit Leader Initials					IDM				Void:		Sheet Number 28	