

PROJECT	Utility Co.	# Conflict #	
Jility Owner: <u>C.5U - Sanitary</u>		Public DPrivate	
SECTION TO BE COMPLETED PRIOR TO NEGOTIATION ME	ETING		
Existing Condition 1. General Location 574. 974+			
2. Utility type: □ Electric ■ Gas □ Communications □ Water 🔏 □ Other	Sanitary 🗆 Cable	TV 🛛 Irr. Canal	
3. Location by: (Utility plat maps; Field located and surveyed: If pothole, # from: I CDOT pothole or I DBC pothole Station: Dist. from HC	HCL used: CL:	Rt. / Lt.	
A. Utility size & type of materials: 12" Sewer line (Abandon Carrier and Casing pipe - Remove cone on E. Side t	F. and Make	to Flow Fil m.H. on Westside	a deate
5. Environmental Concerns: Mouse. 5. Encased: 10 No PYes, if so size & material: 18" STeel			
	D	ate:	_
Proposed Resolution			
Proposed Resolution Recommendation: □ left alone □ modified □ removed □ rel Conflict with: Proposed Resolution Proposed Resolution Pro	located 🗆 upgrada	ed 🗆 abandoned :	in place
Recommendation: □ left alone □ modified □ removed □ rel Conflict with:	n HCL:		
Recommendation: □ left alone □ modified □ removed □ rel Conflict with:	n FICL: ch copy) □ other iy (UC) □ Des esign/Build Contrac	Rt./Lt	
Recommendation: □ left alone □ modified □ removed □ rel Conflict with: Conflict with: This utility may be modified/relocated to: to Station: Dist. from Utility in: □ CD●T ROW □ other public ROW □ Easement (atta- Who will do the Utility Relocation Plan: □ Utility Compan Who will do the construction: □ Utility Company (UC) □ De UC to perform inspection? ⊡No □ EYes, if so conditions: Number of days required for prior notification by DBC for constructio Number of days required by UC or DBC to complete Utility Relocatio days.	n FICL: ch copy) □ other iy (UC) □ De: esign/Build Contract on by UC: on Plan:	Rt./Lt	or (DBC)



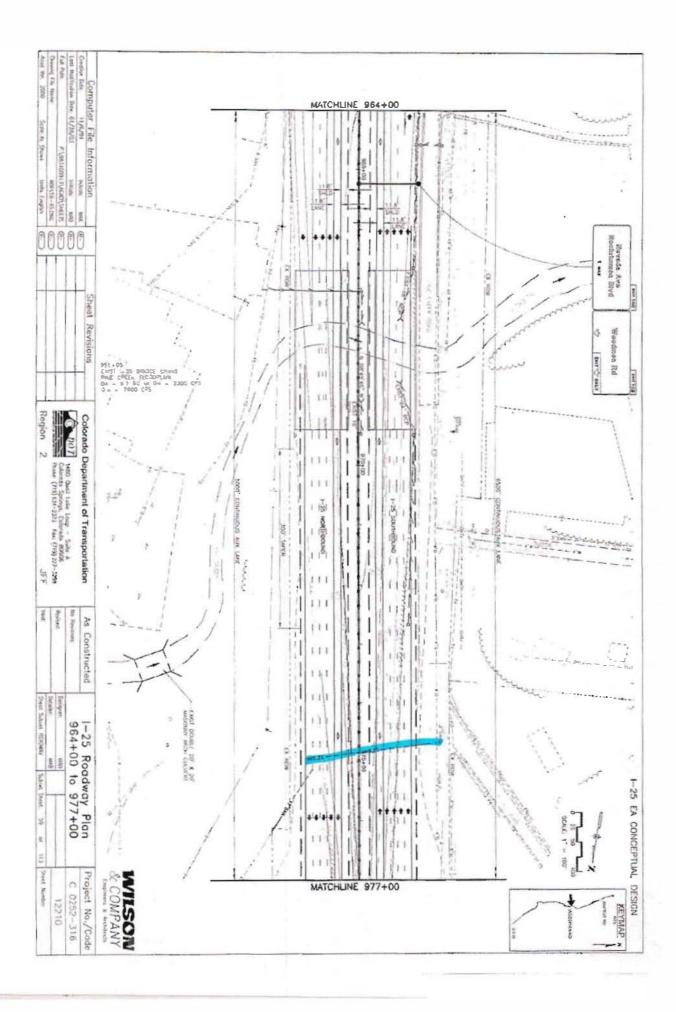

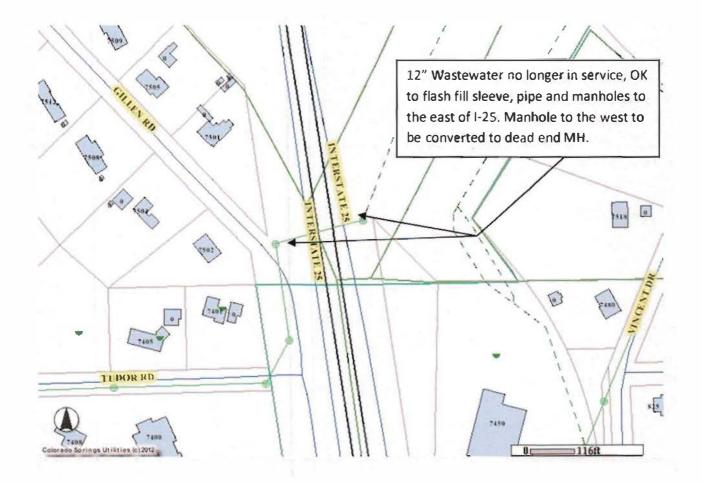

4

,