

COLORADO DEPARTMENT OF HIGHWAYS

PLAN AND PROFILE OF PROPOSED FEDERAL AID PROJECT NO. F.I. 002-2 (25) UNIT 1 STATE HIGHWAY NO. + H 25 UNIT 2 EL PASO COUNTY *culvert lengthening*

FED. ROAD DIST. NO.	STATE	PROJ. NO.	SHEET NO.	TOTAL SHEETS
3	COLO.	F.I. 002-2 (25)	1	1
RIGHT OF WAY		UNIT 1 & UNIT 2		


Rev. 9-10-53 S.W.Z.
Rev. 5-28-54 S.W.Z.
Rev. 12-3-59 E.P.W. Access
Rev. 2/7/61 E.P.W. NOTE

INDEX OF SHEETS
SHEET NO. 1 TITLE SHEET.
2-4 TABULATION OF PROPERTIES.
5-24 PLAN AND PROFILE SHEETS SHOWING R.O.W.
25-29 OWNERSHIP MAP

- CONVENTIONAL SIGNS**
- CENTER LINE
 - RIGHT-OF-WAY LINE
 - TOWNSHIP OR RANGE LINE
 - SECTION LINE
 - QUARTER SECTION LINE
 - SIXTEENTH SECTION LINE
 - PROPERTY OR TRACT LINE
 - CITY LIMITS
 - RAILROAD
 - BARBED WIRE FENCE
 - WOVEN WIRE - COMBINATION FENCE
 - SNOW FENCE
 - TELEPHONE LINE
 - TELEGRAPH LINE
 - POWER LINE
 - PRESENT ROAD (PLAN SHEET)
 - COUNTY LINE
 - ACCESS DENIED BY DEED
 - DEED LINE (CONTROL OF ACCESS)

NOTE
From South end of proj. ROW. sta. 276 +48.8 to North line of USAF Academy property sta. 649 +34.0 the R.O.W. was conveyed to the USAF Academy. For Easement from the Academy for present (1960) S.H. No. 1 see proj. IN 002-2(40)

SCALES OF ORIGINAL TRACINGS
ON PLAN 1 IN. = 100 FT.
ON PROFILE 1 IN. = 100 FT. HORIZONTAL
1 IN. = 10 FT. VERTICAL
GRADE LINE ON PROFILE IS SHOWN AS GRADE OF FINISHED ROAD
GROSS LENGTH OF PROJECT
NET LENGTH OF PROJECT

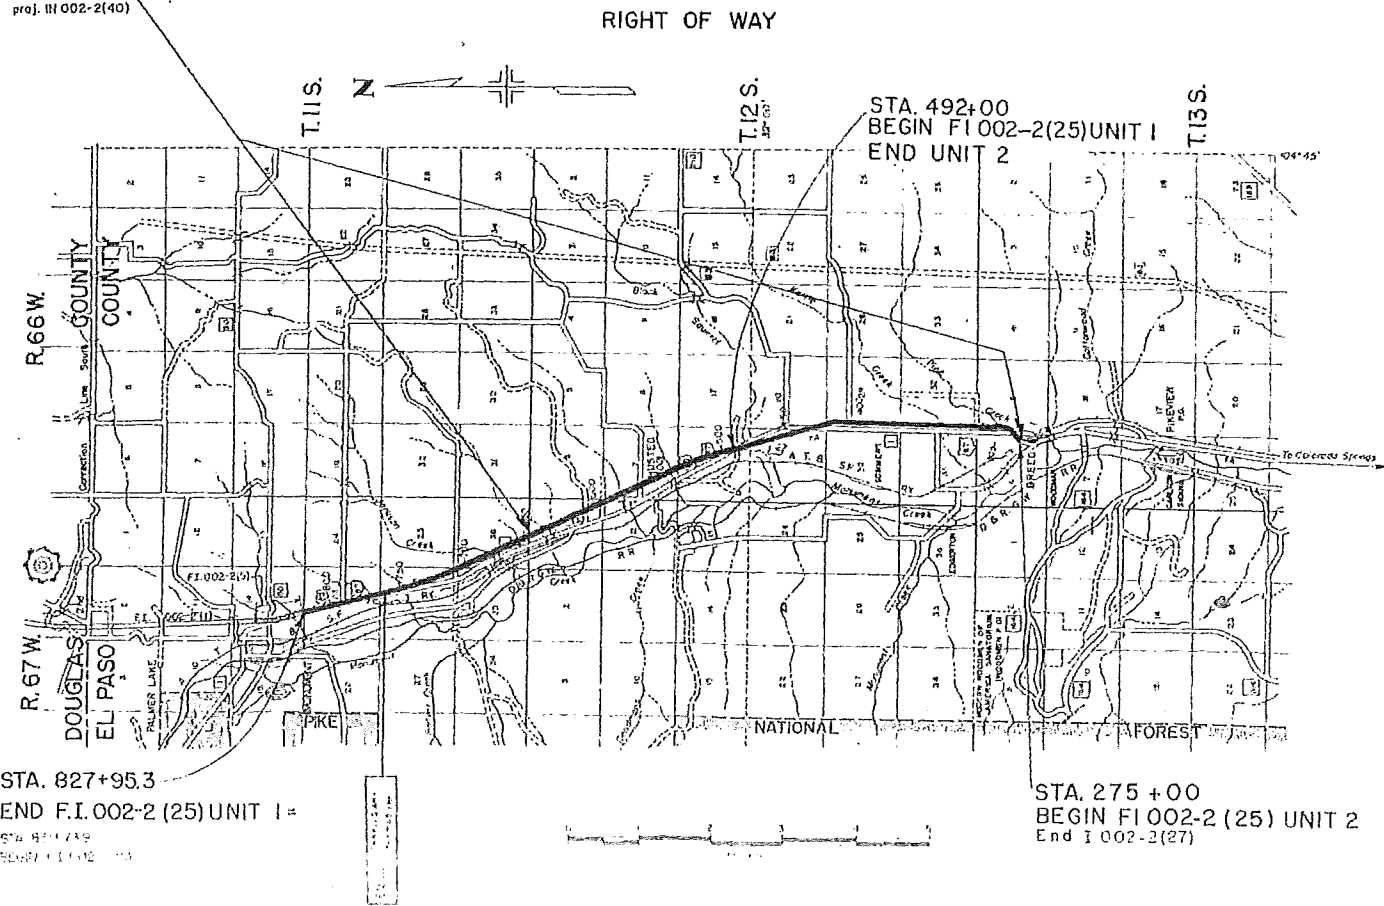

STA. 827+95.3
END F.I. 002-2 (25) UNIT 1
Sta. 827+95.3
Sta. 827+114.2

STA. 275+00
BEGIN F.I. 002-2 (25) UNIT 2
End F.I. 002-2(27)


N.W. 1/4, SEC. 1

NOTE
From South end of prop ROW, sta 276+48.9 to North line of USAF Academy property sta 649+34.8. The ROW was conveyed to the USAF Academy. For Easement from the Academy for present (1961) SH, to see proj #1002-2(43)

FED. ROAD DIST. NO.	STATE	PROJ. NO.	SHEET NO.	TOTAL SHEETS
3	COLO.	E. 1002-2(25)	18	


Re 4, 9-18-53 S.W. 2.
Rev 12-1-58 CPA Access
Rev 2/7/61 CPW. NOTE

original culvert ~1926

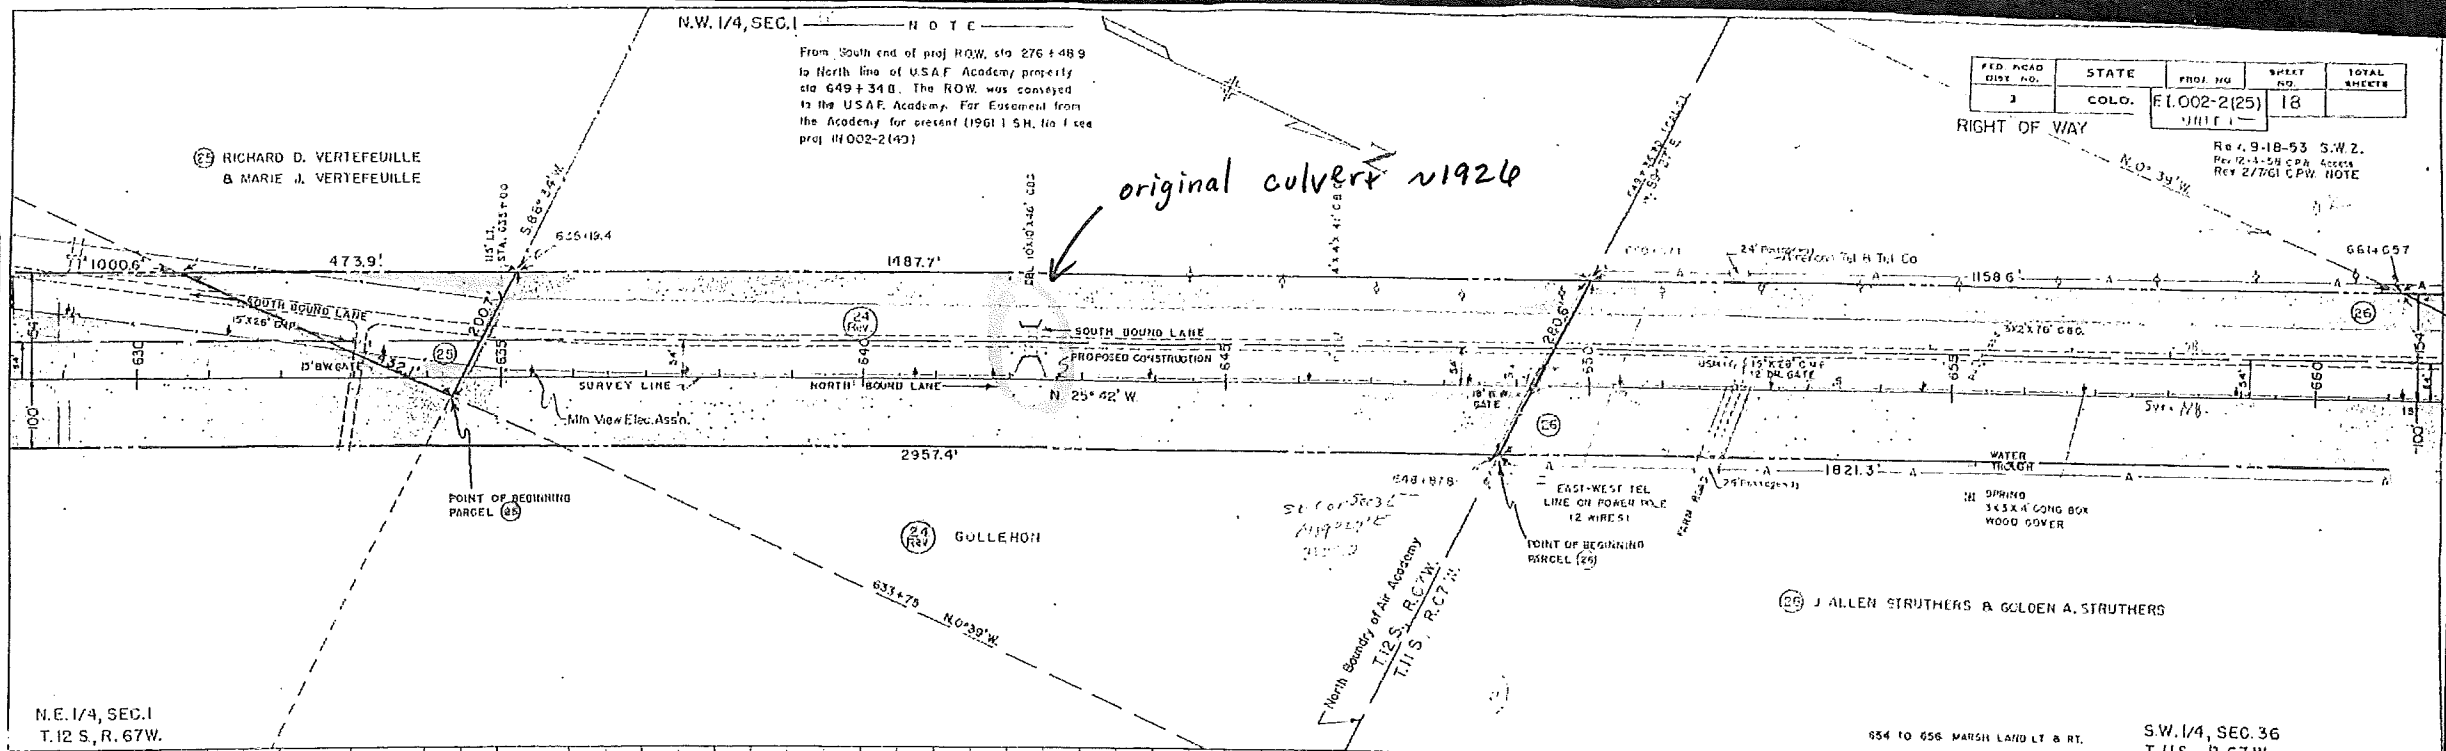

N.E. 1/4, SEC. 1
T. 12 S., R. 67 W.


S.W. 1/4, SEC. 36
T. 11 S., R. 67 W.

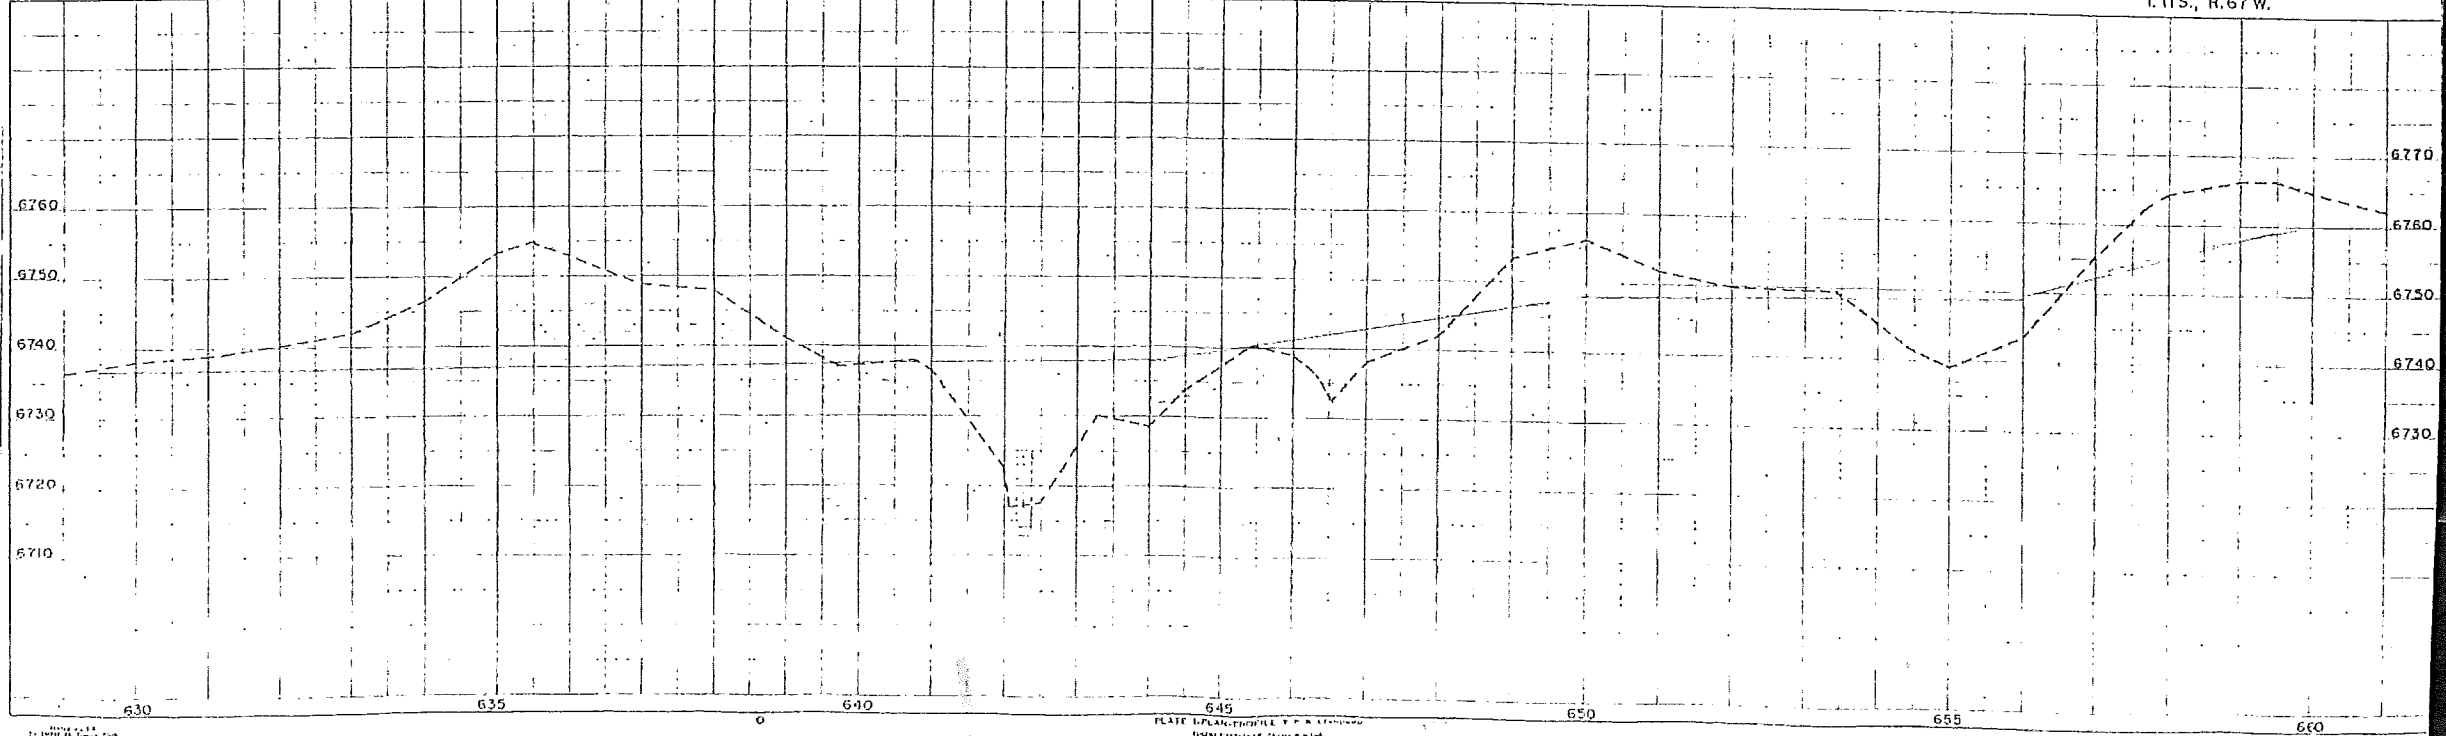

Dimensions & Quantities (see Standard M-50-AW for Wings)


Height of Fill Allowed	Type	Span S	Height H	Slab T	Wall W	Bar Size & Spacing		No. Bars Required	Quantities for One Lin. Ft. of Box		Quantities for Two Headwalls	
						V ₁ Size Spa.	V ₂ Size Spa.		Concrete Cu. Yds.	Steel Lbs.	Concrete Cu. Yds.	Steel Lbs.
35'-0"	2A	2'-0"	2'-0"	6"	8"	3/4"	12"	8	0.232	17.5	1.30	81
30'-0"	3A	3'-0"	3'-0"	7"	8"	3/4"	12"	10	0.299	26.3	1.50	112
20'-0"	4A	4'-0"	4'-0"	7 1/2"	8"	3/4"	12"	12	0.362	31.8	1.50	150
16'-0"	5A	5'-0"	4'-0"	8"	8"	3/4"	12"	16	0.461	37.3	2.10	153
20'-0"	5B	5'-0"	4'-0"	8 1/2"	8"	3/4"	12"	18	0.530	42.7	2.40	157
14'-0"	6A	6'-0"	6'-0"	8 1/2"	8"	3/4"	12"	20	0.579	52.0	2.60	161
20'-0"	6B	6'-0"	5'-0"	10"	8"	3/4"	12"	20	0.500	45.5	2.20	153
12'-0"	7A	7'-0"	7'-0"	9"	9"	3/4"	12"	24	0.598	52.2	2.60	161
15'-0"	7B	7'-0"	10'-0"	9"	9"	3/4"	12"	26	0.605	54.7	2.60	161
20'-0"	7C	7'-0"	11'-0"	9"	9"	3/4"	12"	26	0.654	58.1	2.85	184
10'-0"	8A	8'-0"	9'-0"	10"	10"	3/4"	12"	28	0.704	61.4	3.00	188
16'-0"	8B	8'-0"	11'-0"	10"	10"	3/4"	12"	28	0.753	64.9	3.30	192
20'-0"	8C	8'-0"	12'-0"	10"	10"	3/4"	12"	28	0.871	72.4	3.70	223
7'-0"	9A	9'-0"	10'-0"	11"	11"	3/4"	12"	32	0.720	56.9	2.90	228
14'-0"	9B	9'-0"	12'-0"	11"	11"	3/4"	12"	32	0.820	65.4	3.35	239
20'-0"	9C	9'-0"	14'-0"	11"	11"	3/4"	12"	32	0.938	75.5	3.40	246
5'-0"	10A	10'-0"	10'-0"	12"	12"	3/4"	12"	34	0.887	72.2	3.70	220
10'-0"	10B	10'-0"	12'-0"	12"	12"	3/4"	12"	34	0.972	81.0	3.65	257
16'-0"	10C	10'-0"	14'-0"	12"	12"	3/4"	12"	34	1.072	90.0	3.25	262
5'-0"	11A	11'-0"	11'-0"	12"	12"	3/4"	12"	36	0.938	75.5	3.75	273
9'-0"	11B	11'-0"	12'-0"	12"	12"	3/4"	12"	36	1.023	84.5	3.55	292
13'-0"	11C	11'-0"	14'-0"	12"	12"	3/4"	12"	36	1.084	91.1	3.10	257
5'-0"	12A	12'-0"	12'-0"	12"	12"	3/4"	12"	38	0.887	72.2	3.30	269
10'-0"	12B	12'-0"	14'-0"	12"	12"	3/4"	12"	38	0.937	76.9	3.50	268
4'-0"	13A	13'-0"	13'-0"	12"	12"	3/4"	12"	40	0.844	66.0	3.75	274
8'-0"	13B	13'-0"	14'-0"	12"	12"	3/4"	12"	40	0.905	75.8	3.40	235
4'-0"	14A	14'-0"	14'-0"	13"	13"	3/4"	12"	42	0.866	63.2	3.60	243
8'-0"	14B	14'-0"	15'-0"	13"	13"	3/4"	12"	42	0.927	72.7	3.40	247
10'-0"								44	1.089	90.5	4.40	251

SINGLE CONCRETE BOX CULVERT

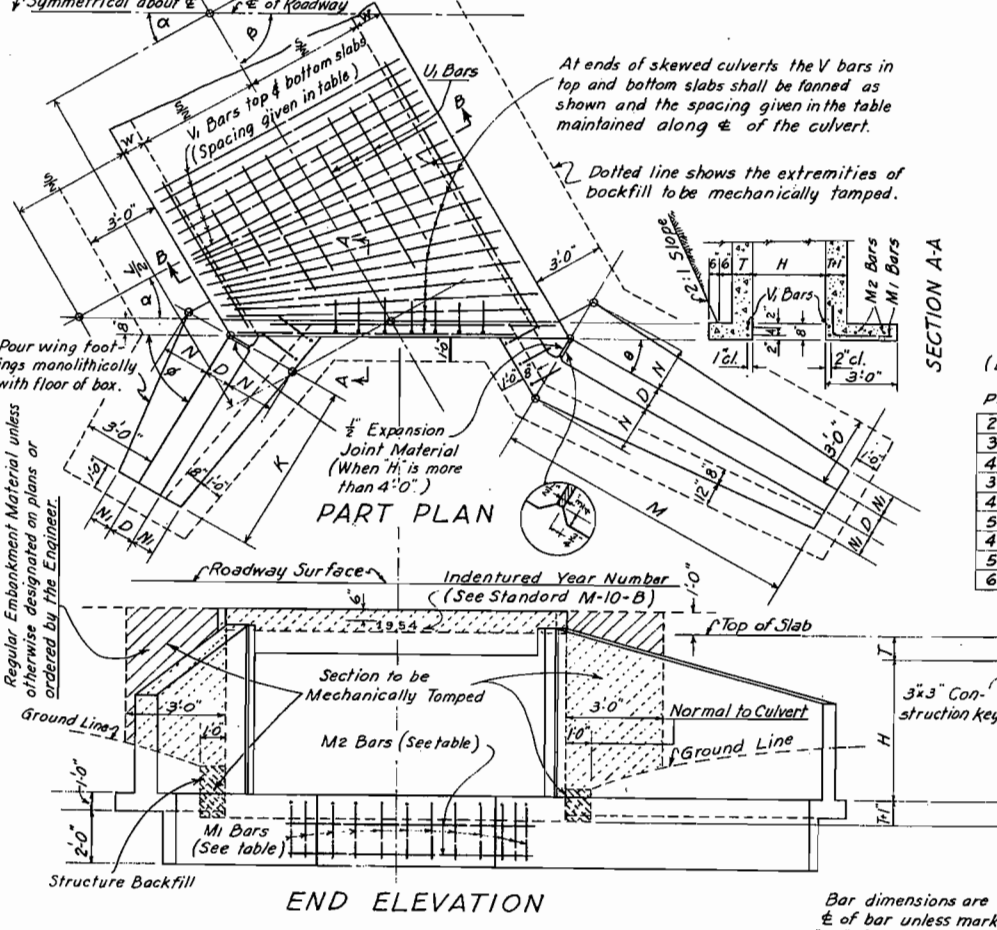

Bar List for Culvert & Headwalls (See Standard M-50-AW for Wings)

Mark	Size	No. Req'd.	Type	Length
V ₁	See table	10 + 24L/Spa.	I	S + 2W - 6
W ₁	See table	6 + 24L/Spa.	I	H + 2T - 5
U ₁	1/2"	See table	I	L + 1'0"
M ₁	1/2"	See table	II	3'-6"
M ₂	1/2"	4	I	S + 2W - 6 / Cos α

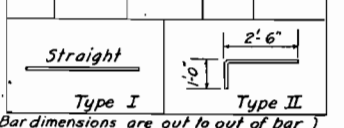


Possible Combinations (Span & Height)

2' x 2'	5' x 5'	9' x 5'	10' x 7'	11' x 8'	11' x 10'
3' x 2'	7' x 4'	8' x 6'	9' x 8'	10' x 9'	14' x 8'
4' x 2'	6' x 5'	7' x 7'	12' x 6'	13' x 7'	13' x 9'
3' x 3'	8' x 4'	9' x 6'	11' x 7'	12' x 8'	12' x 10'
4' x 3'	7' x 5'	8' x 7'	13' x 6'	14' x 7'	14' x 9'
5' x 3'	6' x 6'	10' x 6'	10' x 8'	11' x 9'	13' x 10'
4' x 4'	8' x 5'	9' x 7'	9' x 9'	10' x 10'	14' x 10'
5' x 4'	6' x 7'	8' x 8'	12' x 7'	13' x 8'	
6' x 4'	7' x 6'	11' x 6'	14' x 6'	12' x 9'	

STANDARD M-50-A

Use in conjunction with Standard M-50-AW

FED. ROAD DIV. NO.	DISTRICT	SHEET NO.	TOTAL SHEETS
9	COLO.	002-2(40) 34	

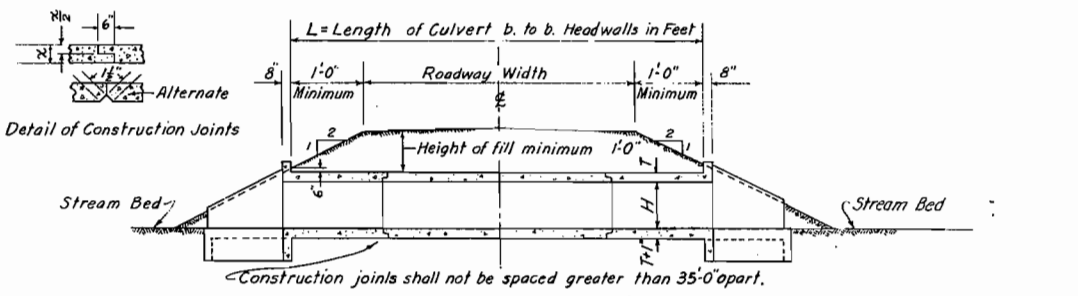

TYPICAL SECTION THROUGH CULVERT

Dimensions & Quantities (see Standard M-50-AW for Wings)

Height of Fill Allowed	Type	Span S	Height H	Slab T	Wall W	Bar Size & Spacing		No. Bars Required	Quantities for One Lin. Ft. of Box		Quantities for Two Headwalls	
						V ₁ Size Spa.	V ₂ Size Spa.		Concrete Cu. Yds.	Steel Lbs.	Concrete Cu. Yds.	Steel Lbs.
10'-0"	6'-6"-A	6'-0"	4'-0"	8 1/2"	8"	1/2"	12"	32	1.000	112.3	3.85	327
15'-0"	6'-6"-B	6'-0"	4'-0"	9 1/2"	8"	1/2"	12"	32	1.148	123.1	4.85	343
20'-0"	6'-6"-C	6'-0"	4'-0"	10 1/2"	8"	1/2"	12"	32	1.282	128.5	5.05	351
10'-0"	8'-8"-A	8'-0"	4'-0"	10"	10"	1/2"	12"	40	1.161	125.7	4.90	337
15'-0"	8'-8"-B	8'-0"	4'-0"	11"	10"	1/2"	12"	40	1.309	141.4	5.10	339
20'-0"	8'-8"-C	8'-0"	4'-0"	12 1/2"	10"	1/2"	12"	40	1.477	174.4	5.80	506
5'-0"	10'-10"-A	10'-0"	8'-0"	10"	12"	5/8"	12"	48	1.569	179.8	6.05	514
10'-0"	10'-10"-B	10'-0"	8'-0"	12"	12"	5/8"	12"	48	1.727	197.4	6.40	524
15'-0"	10'-10"-C	10'-0"	8'-0"	14"	12"	5/8"	12"	48	1.869	207.9	6.65	533
5'-0"	12'-12"-A	12'-0"	8'-0"	12"	12"	5/8"	12"	56	1.763	202.0	6.00	513
10'-0"	12'-12"-B	12'-0"	8'-0"	14"	12"	5/8"	12"	56	1.938	224.6	6.55	529
15'-0"	12'-12"-C	12'-0"	8'-0"	16"	12"	5/8"	12"	56	2.041	225.7	6.75	537
5'-0"	14'-14"-A	14'-0"	8'-0"	12"	12"	5/8"	12"	64	1.935	228.3	7.40	714
10'-0"	14'-14"-B	14'-0"	8'-0"	14"	12"	5/8"	12"	64	2.157	259.8	7.95	733
15'-0"	14'-14"-C	14'-0"	8'-0"	16"	12"	5/8"	12"	64	2.380	255.2	8.70	752
5'-0"	16'-16"-A	16'-0"	8'-0"	12"	12"	5/8"	12"	72	2.202	275.5	9.55	771
10'-0"	16'-16"-B	16'-0"	8'-0"	14"	12"	5/8"	12"	72	2.442	242.5	8.20	740
15'-0"	16'-16"-C	16'-0"	8'-0"	16"	12"	5/8"	12"	72	2.664	258.0	8.90	759
5'-0"	18'-18"-A	18'-0"	8'-0"	12"	12"	5/8"	12"	80	2.886	282.6	9.75	778
10'-0"	18'-18"-B	18'-0"	8'-0"	14"	12"	5/8"	12"	80	3.170	325.5	10.00	784
15'-0"	18'-18"-C	18'-0"	8'-0"	16"	12"	5/8"	12"	80	3.416	365.1	9.85	870
5'-0"	20'-20"-A	20'-0"	8'-0"	12"	12"	5/8"	12"	90	2.973	294.5	10.05	876
10'-0"	20'-20"-B	20'-0"	8'-0"	14"	12"	5/8"	12"	90	3.283	315.0	10.90	895
15'-0"	20'-20"-C	20'-0"	8'-0"	16"	12"	5/8"	12"	90	3.528	354.1	11.15	902
5'-0"	22'-22"-A	22'-0"	8'-0"	12"	12"	5/8"	12"	100	3.638	384.7	10.55	889
10'-0"	22'-22"-B	22'-0"	8'-0"	14"	12"	5/8"	12"	100	3.855	372.0	11.60	1003
15'-0"	22'-22"-C	22'-0"	8'-0"	16"	12"	5/8"	12"	100	4.077	392.9	12.50	1023
5'-0"	24'-24"-A	24'-0"	8'-0"	12"	12"	5/8"	12"	11				

STANDARD M-50-AW

Use in conjunction with Standard M-50-A and M-55-A


FED. ROAD DIV. NO.	DISTRICT	SHEET NO.	TOTAL SHEETS
9	COLO.	002-2(40) 35	

Rev. 5-2-56, Deleted Finish Note, J.C.R.

TABLE SHOWING VALUES OF K AND M WHEN β AND H ARE GIVEN

β	α	φ	θ	H=2'-0"		H=3'-0"		H=4'-0"		H=5'-0"		H=6'-0"		H=7'-0"		H=8'-0"		H=9'-0"		H=10'-0"	
				K	M	K	M	K	M	K	M	K	M	K	M	K	M	K	M	K	M
45°	45°	67°30'	22°30'	2.4	6.2	3.7	8.7	4.0	11.7	5.1	14.2	6.1	16.5	7.9	18.8	8.8	20.1	9.8	23.2	10.7	25.5
60°	30°	60°	30°	2.9	4.9	3.1	6.7	3.5	8.1	4.0	10.7	4.5	12.7	5.3	14.5	6.3	16.0	7.3	17.9	8.3	19.6
75°	15°	52°30'	37°30'	3.0	3.1	4.2	5.5	5.7	7.3	6.1	8.1	7.3	9.5	8.1	10.4	8.1	10.4	9.0	11.3	11.4	13.9
90°	0°	45°	45°	3.4	3.4	4.8	4.8	6.3	6.3	7.8	7.8	8.1	8.1	10.2	10.2	11.4	11.4	12.7	12.7	13.9	13.9
105°	15°	37°30'	52°30'	3.1	3.0	5.5	4.2	7.3	5.7	9.5	8.1	10.4	9.0	11.3	9.9	13.2	11.4	14.7	12.3	16.0	12.3
120°	30°	30°	60°	4.9	2.9	6.7	3.1	8.1	3.5	10.7	4.0	12.7	7.3	14.5	8.3	16.0	9.3	17.9	10.3	19.6	11.3
135°	45°	22°30'	67°30'	6.2	2.4	8.7	3.7	11.7	4.0	14.2	5.1	16.5	6.1	18.8	7.9	20.1	8.8	23.2	9.8	25.5	10.7


β EQUALS THE ANGLE BETWEEN β OF CULVERT AND α OF ROADWAY. α EQUALS THE ANGLE BETWEEN α OF CULVERT AND A NORMAL TO α OF ROADWAY.
 φ AND θ ARE ANGLES BETWEEN THE WINGWALL AND A LINE PARALLEL WITH THE CENTER LINE OF ROADWAY.
 EXAMPLE FOR USING THE ABOVE TABLE. SUPPOSE A STREAM MAKES AN ANGLE OF β=65° WITH THE CENTER LINE OF ROADWAY. THEN, FROM THE TABLE, SELECT THE NEAREST ANGLE β=60°. THEN α, φ AND θ EQUAL 30°, 60° AND 30° RESPECTIVELY. IF THE DESIRED HEIGHT "H" OF CULVERT IS 8'-0", THEN "K" AND "M" WILL BE 9'3" AND 16'-0". LOCATE THE WING DETAIL WHEN H=8'-0" ON THIS SHEET.

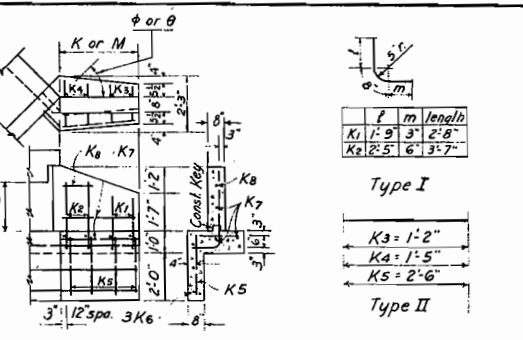

BAR LIST & QUANTITIES FOR ONE WING WHEN H=2'-0"

When φ or θ equals	Number of Bars Required								Length of Bars								Quantities for One Wing					
	K1	K2	K3	K4	K5	3-K6	3-K7	1-K8	F1	F2	F3	F4	F5	F6	F7	3-F8	7-F9	1-F10	1-F11	Concrete	Steel	


WING DETAIL WHEN H=2'-0"

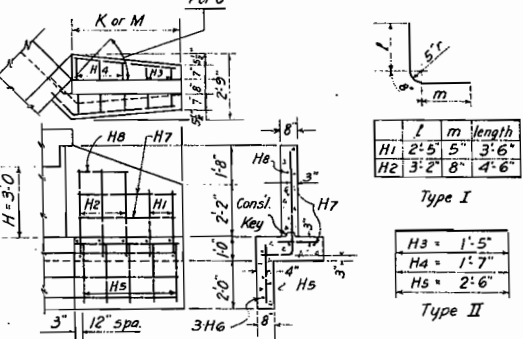

BAR LIST & QUANTITIES FOR ONE WING WHEN H=3'-0"

When φ or θ equals	Number of Bars Required								Length of Bars								Quantities for One Wing					
	H1	H2	H3	H4	H5	3-H6	4-H7	1-H8	E1	E2	E3	E4	E5	E6	E7	3-E8	7-E9	1-E10	1-E11	Concrete	Steel	


WING DETAIL WHEN H=3'-0"

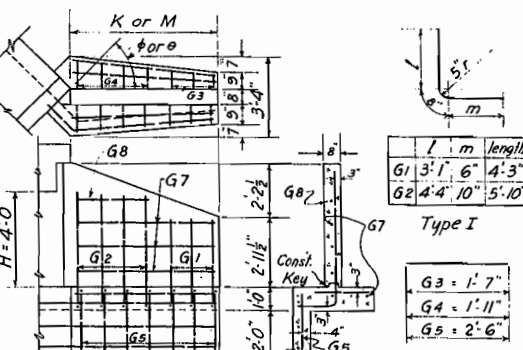

BAR LIST & QUANTITIES FOR ONE WING WHEN H=4'-0"

When φ or θ equals	Number of Bars Required								Length of Bars								Quantities for One Wing					
	G1	G2	G3	G4	G5	3-G6	7-G7	1-G8	D1	D2	D3	D4	D5	D6	D7	3-D8	7-D9	1-D10	1-D11	Concrete	Steel	


WING DETAIL WHEN H=4'-0"

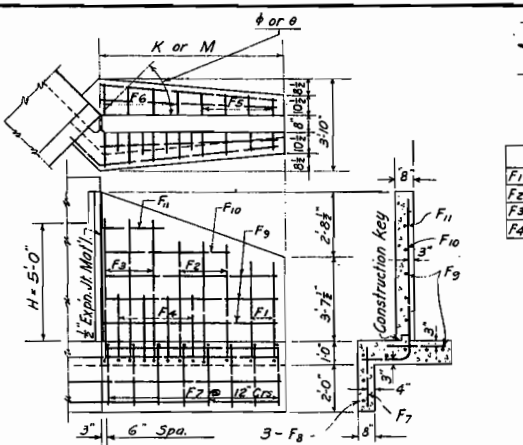

BAR LIST & QUANTITIES FOR ONE WING WHEN H=5'-0"

When φ or θ equals	Number of Bars Required								Length of Bars								Quantities for One Wing							
	F1	F2	F3	F4	F5	F6	F7	3-F8	7-F9	1-F10	1-F11	Concrete	Steel											


WING DETAIL WHEN H=5'-0"

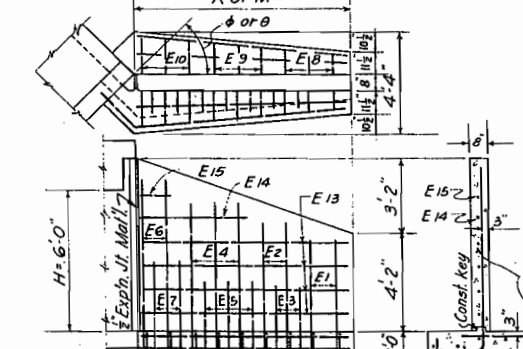

BAR LIST & QUANTITIES FOR ONE WING WHEN H=6'-0"

When φ or θ equals	Number of Bars Required								Length of Bars								Quantities for One Wing						
	E1	E2	E3	E4	E5	E6	E7	3-E8	7-E9	1-E10	1-E11	Concrete	Steel										

WING DETAIL WHEN H=6'-0"

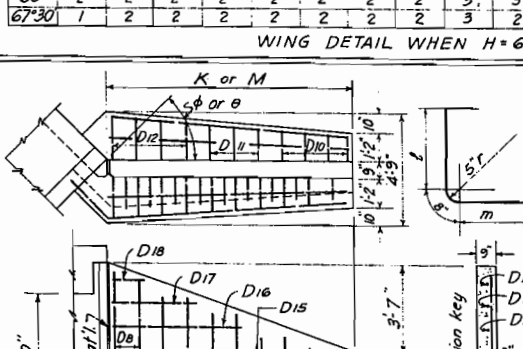

BAR LIST & QUANTITIES FOR ONE WING WHEN H=7'-0"

When φ or θ equals	Number of Bars Required								Length of Bars								Quantities for One Wing	
	D1	D2	D3	D4	D5	D6	D7	3-D8	7-D9	1-D10	1-D11	Concrete	Steel					
22°30'																		