


CHOOSE YOUR MOVE



Southbound McCaslin to Eastbound US 36/Loop Ramp Closure Wednesday, Jan. 28, 2015

The existing loop ramp from southbound McCaslin Boulevard to eastbound US 36 is scheduled to permanently close the night of Wednesday, Jan. 28 starting at 9 p.m. This closure is necessary to construct the new eastbound US 36 dedicated RTD bus ramp, which will mirror the nearly completed one on westbound US 36 and McCaslin. Prior to the loop ramp closure, the new southbound McCaslin Boulevard to eastbound US 36 on-ramp will be completed, and traffic will be directed to the new ramp for access to eastbound US 36. During this phase of construction, traffic will yield at a temporary light to make a left turn onto the eastbound ramp. Alternate routes are recommended on Thursday, Jan. 29 during this transition, as traffic becomes familiar with the new traffic pattern. Back-ups are expected in the area. Once the bridge is complete, traffic will have free left and right turns onto US 36 with the implementation of the Diverging Diamond Interchange (DDI). To learn more about a DDI, including how to drive one go to www.us36expresslanes.com.

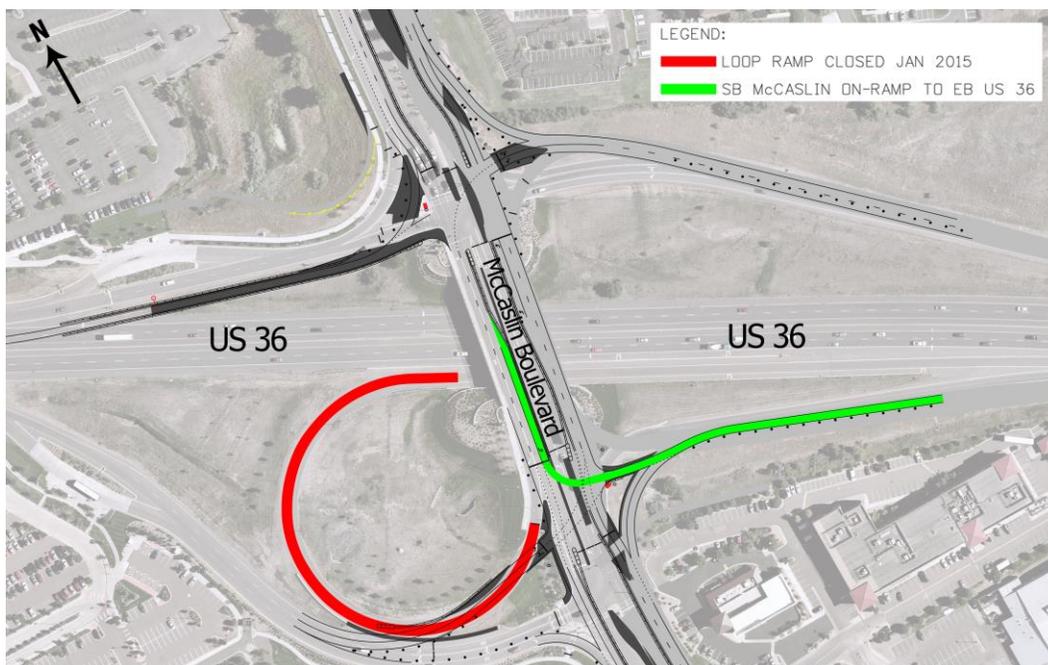

For more information call the project hotline at 303-404-7042.

