



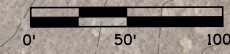

Know what's below.
Call before you dig.

kingem 8:46:13 AM J:_Transportation\W\X\7000.CDDT_us36_D-B-7000CADD\17516_Design\Exhibits\17516_200scale_Plan_CoolCreek_Enviro-RDW_Impacts.dgn

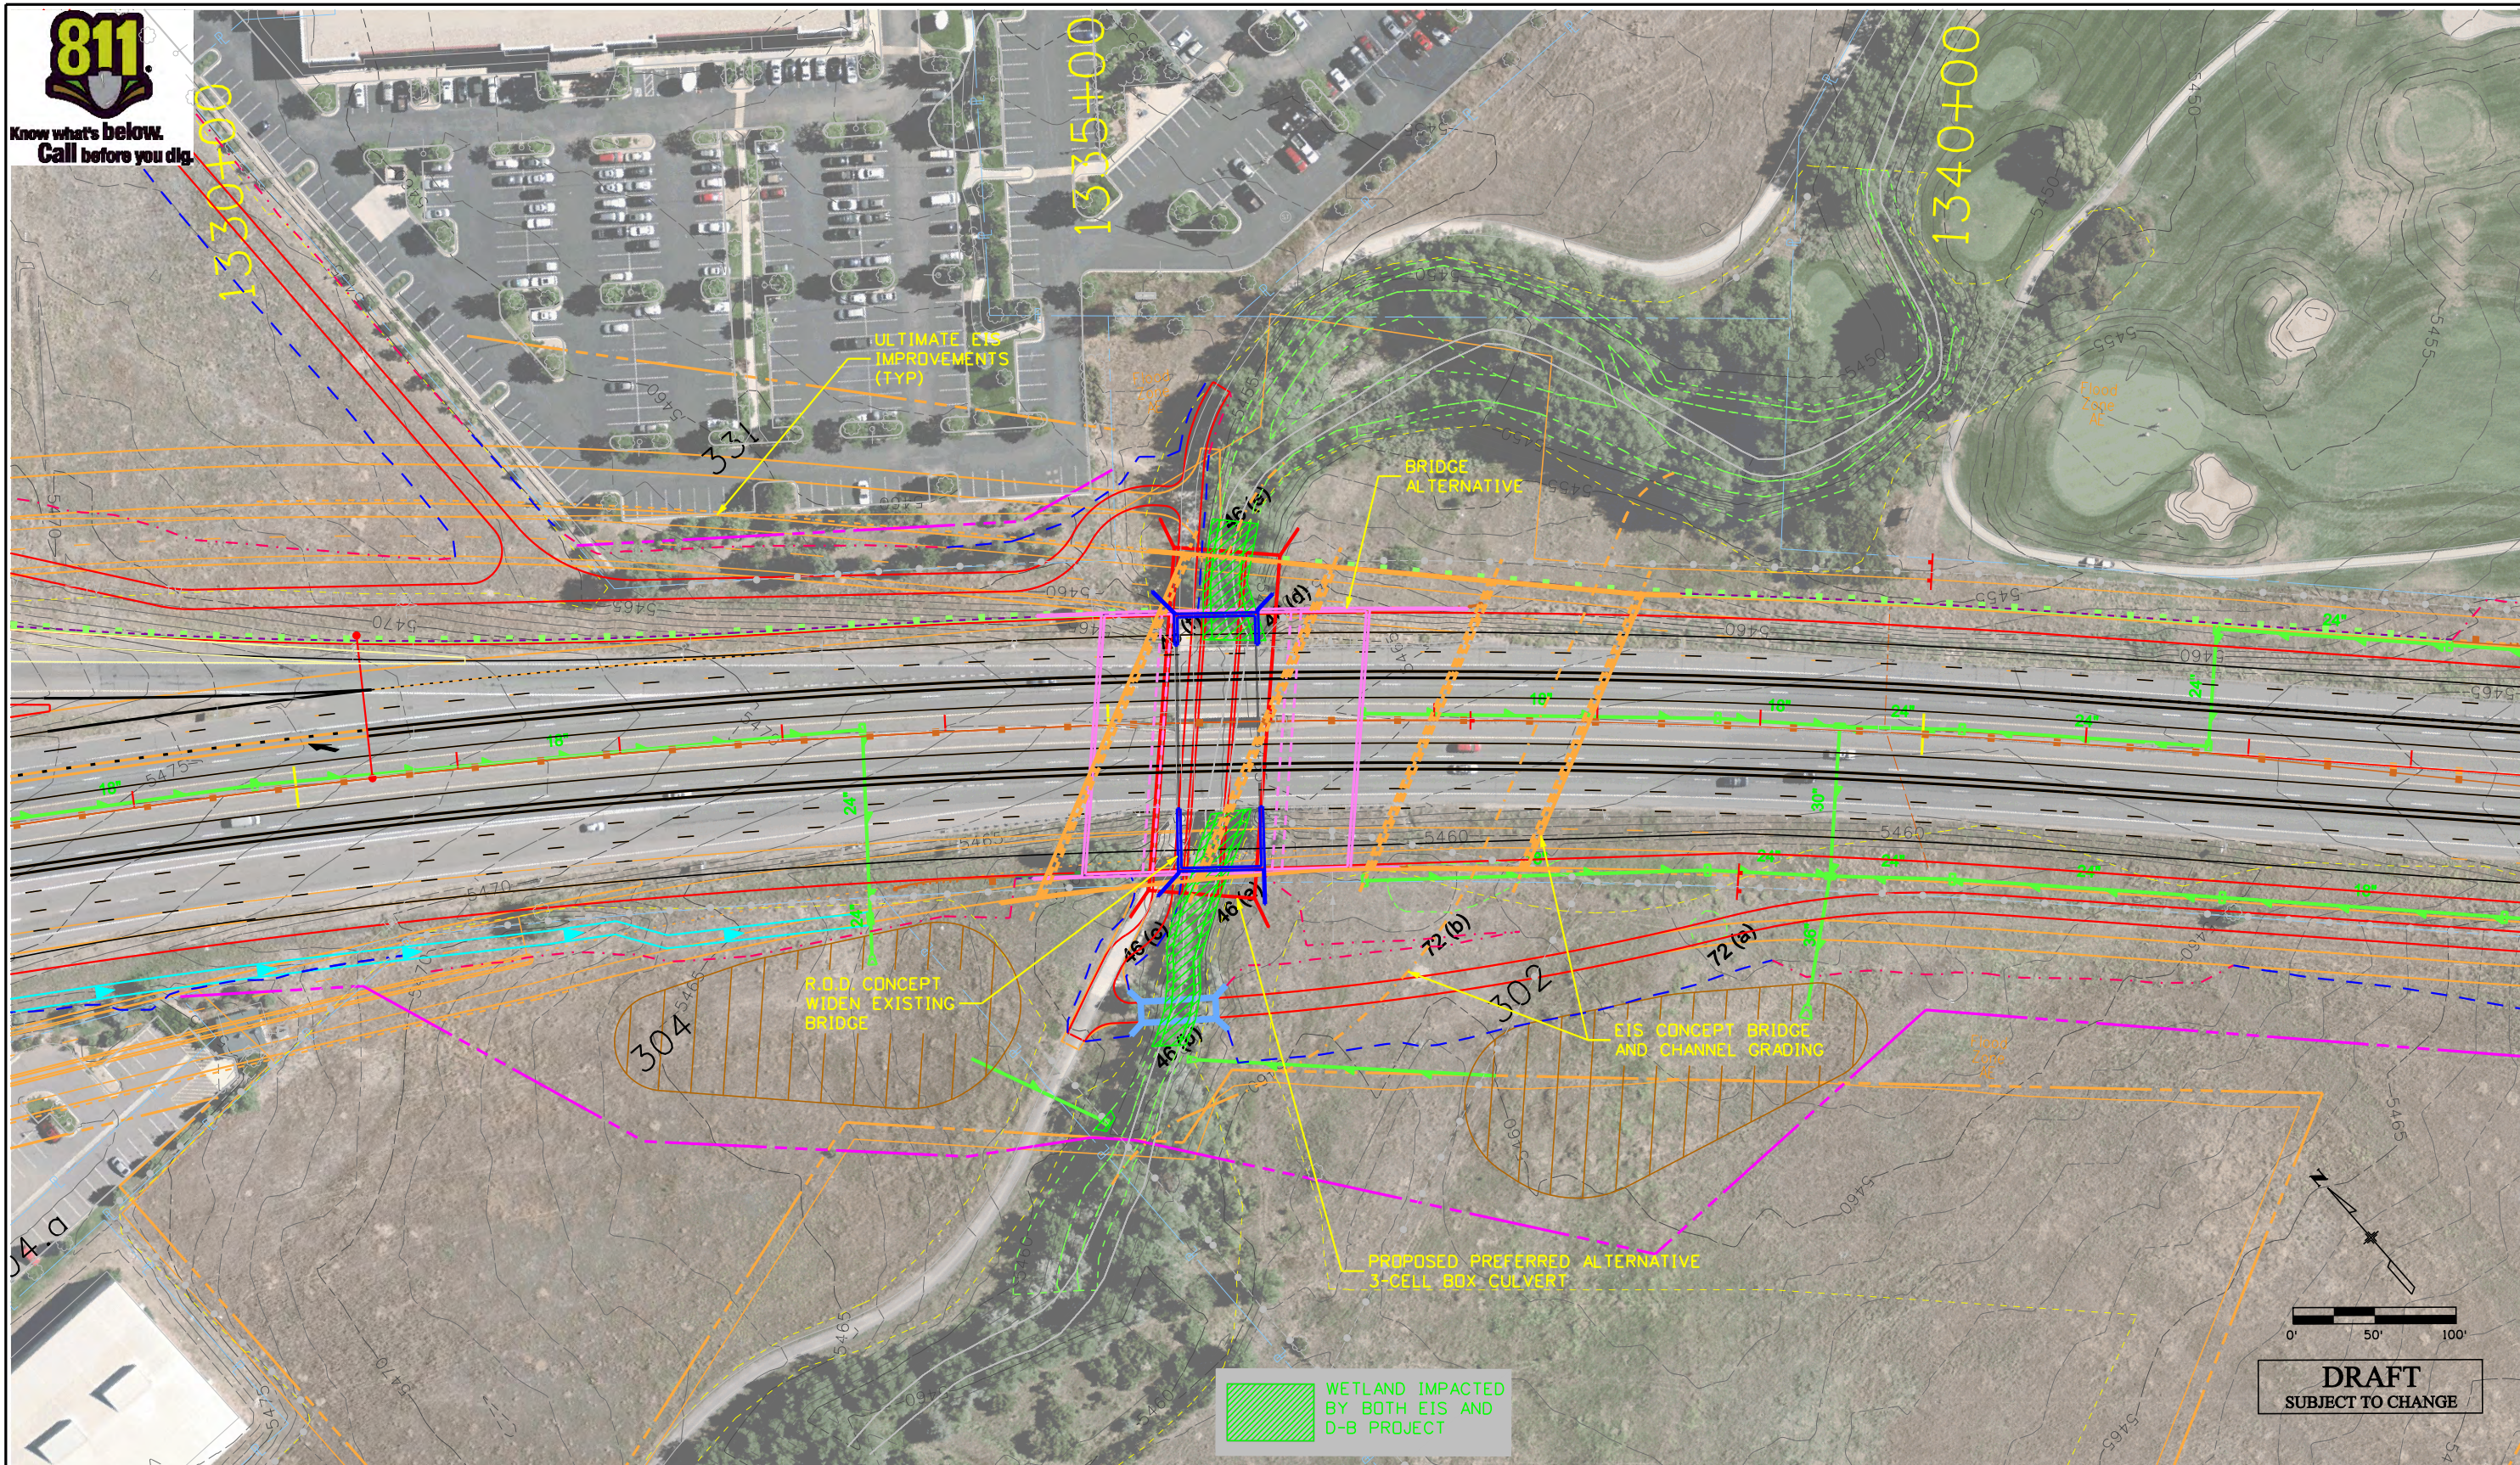

DRAFT
SUBJECT TO CHANGE

Print Date: 12/9/2011
 File Name: 17516_200scale_Plan_CoolCreek_Enviro-RDW_Impacts.dgn
 Horiz. Scale: 1"=200' Vert. Scale: As Noted

Sheet Revisions		
No.	Comments	Init.
0000		

Colorado Department of Transportation



2000 South Holly Street
 Denver, Co 80222
 Phone: 303-972-9112 FAX: 303-972-9114

As Constructed
No Revisions:
Revised:
Void:

EXHIBIT 2 COAL CREEK IMPACTS		
Designer:	Structure Numbers	
Detailer:	Subset Sheets:	
Sheet Subset:		

Project No./Code
NH 0361-093
17516
Sheet Number