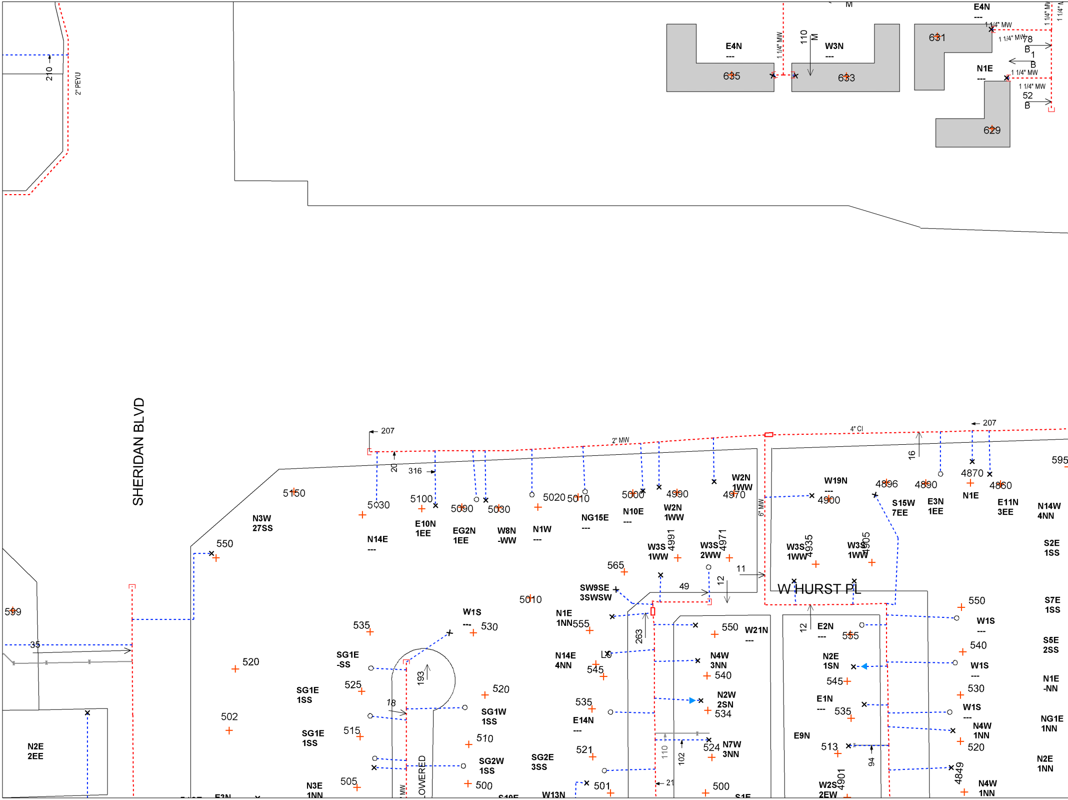
SHERIDAN BLVD
W HURST PL
2" PEYU
210
E4N

635
E4N
---
1 1/4" MW
110
M
W3N

633
M
631
1 1/4" MW
78
B
1
B
N1E
---
1 1/4" MW
1 1/4" MW
52
B
629
207
2" MW
4" CI
207
316
20
5150
N3W
27SS
5030
5100
E10N
1EE
N14E

5090
EG2N
1EE
5030
W8N
-WW
N1W

5020
5010
NG15E

5000
N10E

4990
W2N
1WW
W2N
1WW
4970
6" MW
W19N

4900
4896
S15W
7EE
4890
E3N
1EE
4870
N1E
4860
E11N
3EE
N14W
4NN
595
16
W3S
1WW
4991
W3S
2WW
4971
W3S
1WW
4935
W3S
1WW
4905
S2E
1SS
565
11
12
49
SW9SE
3SWSW
550
5010
N1E
1NN
555
263
550
W21N

12
E2N

555
550
W1S

S7E
1SS
599
35
W1S

535
530
SG1E
-SS
520
193
18
N14E
4NN
545
N4W
3NN
540
N2E
1SN
545
540
W1S

S5E
2SS
530
N1E
-NN
SG1E
1SS
525
520
SG1W
1SS
E14N

535
N2W
2SN
534
E1N

535
W1S

NG1E
1NN
502
515
510
N4W
1NN
N2E
2EE
SG1E
1SS
E9N
513
520
110
102
524
N7W
3NN
521
94
SG2W
1SS
SG2E
3SS
N2E
1NN
4849
LOWERED
505
500
501
500
21
N3E
1NN
W13N
W2S
2EW
4901
N4W
1NN

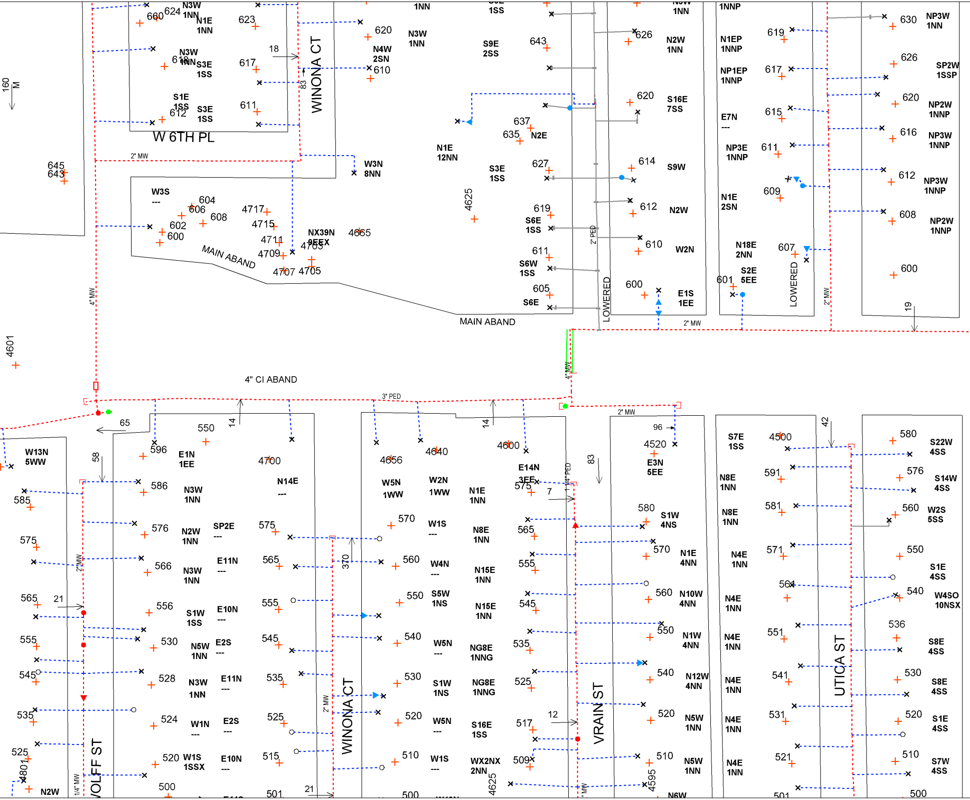
W 6TH PL
WINONA CT
MAIN ABAND
LOWERED
4" CI ABAND
3" PED
2" MW
4" MW
2" PED
1/4" MW
1/4" PED
WOLFF ST
WINONA CT
VRAIN ST
UTICA ST
160 M
4601
645
643
660
624
N3W 1NN
N1E 1NN
623
N3W 1NN
618
S3E 1SS
617
18
S1E 1SS
612
S3E 1SS
611
83
620
N4W 2SN
610
N3W 1NN
1NN
1SS
S9E 2SS
643
626
N2W 1NN
1NN
W3N 8NN
N1E 12NN
637
635
N2E
620
S16E 7SS
S3E 1SS
627
614
S9W
4625
619
S6E 1SS
612
N2W
610
W2N
611
S6W 1SS
605
S6E
600
E1S 1EE
W3S ---
604
606
608
602
600
4717
4715
4711
4709
NX39N 9EEX
4703
4665
4707
4705
1NNP
N1EP 1NNP
NP1EP 1NNP
E7N ---
NP3E 1NNP
N1E 2SN
N18E 2NN
S2E 5EE
601
619
617
615
611
609
607
630
NP3W 1NN
626
SP2W 1SSP
620
NP2W 1NNP
616
NP3W 1NNP
612
NP3W 1NNP
608
NP2W 1NNP
600
19
65
W13N 5WW
58
585
575
565
21
555
545
535
525
4801
N2W
550
14
596
E1N 1EE
4700
586
N3W 1NN
N14E ---
576
N2W 1NN
SP2E ---
575
566
N3W 1NN
E11N ---
565
556
S1W 1SS
E10N ---
555
530
N5W 1NN
E2S ---
545
528
N3W 1NN
E11N ---
535
524
W1N ---
E2S ---
525
520
W1S 1SSX
E10N ---
515
500
501
21
370
2" MW
4656
4640
14
4600
W5N 1WW
W2N 1WW
N1E 1NN
E14N 3EEX
575
7
570
W1S ---
N8E 1NN
565
560
W4N ---
N15E 1NN
555
550
S5W 1NS
N15E 1NN
545
540
W5N ---
NG8E 1NNG
535
530
S1W 1NS
NG8E 1NNG
525
520
W5N ---
S16E 1SS
517
12
510
W1S ---
WX2NX 2NN
509
4625
500
96
4520
E3N 5EE
83
580
S1W 4NS
570
N1E 4NN
560
N10W 4NN
550
N1W 4NN
540
N12W 4NN
520
N5W 1NN
510
N5W 1NN
4595
N6W
S7E 1SS
4500
N8E 1NN
591
N8E 1NN
581
N4E 1NN
571
N4E 1NN
561
N4E 1NN
551
N4E 1NN
541
N4E 1NN
531
N4E 1NN
521
501
42
580
S22W 4SS
576
S14W 4SS
560
W2S 5SS
550
S1E 4SS
540
W4SO 10NSX
536
S8E 4SS
530
S8E 4SS
520
S1E 4SS
510
S7W 4SS
500

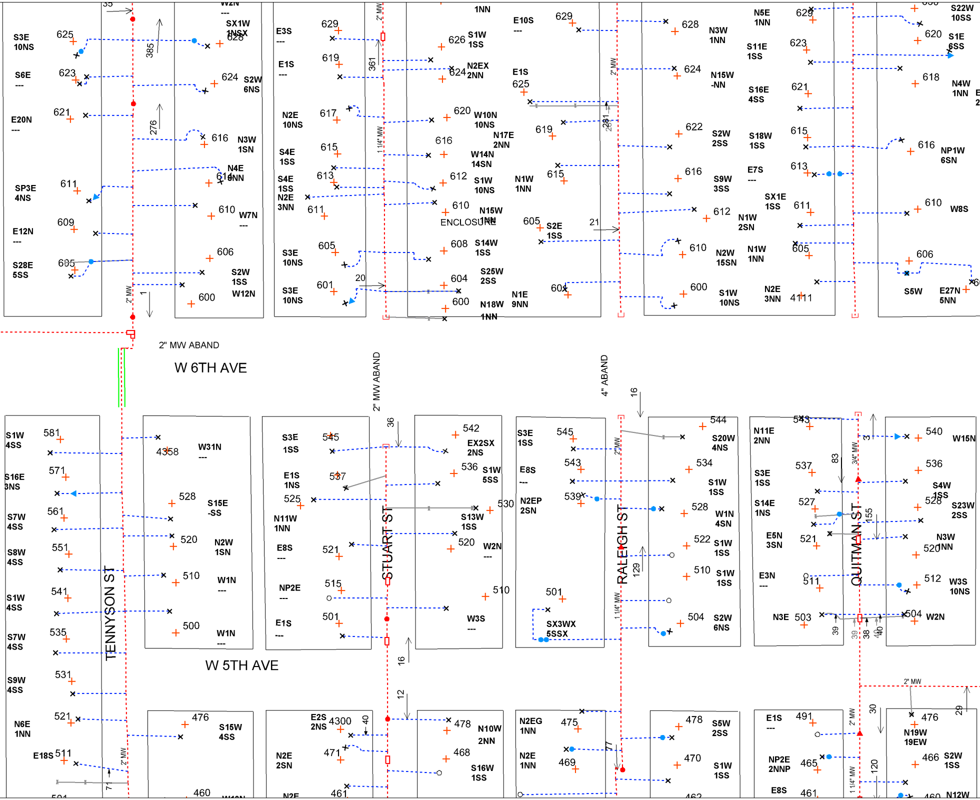

W 6TH AVE
W 5TH AVE
TENNYSON ST
STUART ST
RALEIGH ST
QUITMAN ST
2" MW ABAND
2" MW ABAND
4" ABAND
2" MW
1 1/4" MW
3/4" MW
ENCLOSURE
625
S3E 10NS
623
S6E ---
621
E20N ---
611
SP3E 4NS
609
E12N ---
605
S28E 5SS
628
SX1W 1NSX
624
S2W 6NS
616
N3W 1SN
614
N4E 6NN
610
W7N ---
606
S2W 1SS
600
W12N
629
E3S ---
619
E1S ---
617
N2E 10NS
615
S4E 1SS
613
S4E 1SS
N2E 3NN
611
605
S3E 10NS
601
S3E 10NS
626
S1W 1SS
624
N2EX 2NN
620
W10N 10NS
N17E 2NN
616
W14N 14SN
612
S1W 10NS
610
N15W 1NN
608
S14W 1SS
604
S25W 2SS
600
N18W 1NN
1NN
E10S ---
629
E1S
625
619
N1W 1NN
615
605
S2E 1SS
N1E 9NN
60
628
N3W 1NN
624
N15W -NN
622
S2W 2SS
616
S9W 3SS
612
N1W 2SN
610
N2W 15SN
600
S1W 10NS
N5E 1NN
629
S11E 1SS
623
S16E 4SS
621
S18W 1SS
615
E7S ---
613
SX1E 1SS
611
N1W 1NN
605
N2E 3NN
4111
S22W 10SS
620
S1E 6SS
618
N4W 1NN
616
NP1W 6SN
610
W8S
606
S5W
E27N 5NN
581
S1W 4SS
571
S16E 3NS
561
S7W 4SS
551
S8W 4SS
541
S1W 4SS
535
S7W 4SS
531
S9W 4SS
521
N6E 1NN
511
E18S
501
4358
W31N ---
528
S15E -SS
520
N2W 1SN
510
W1N ---
500
W1N ---
476
S15W 4SS
460
W10N
545
S3E 1SS
537
E1S 1NS
525
N11W 1NN
521
E8S ---
515
NP2E ---
501
E1S ---
4300
E2S 2NS
471
N2E 2SN
461
N2E
542
EX2SX 2NS
536
S1W 5SS
530
S13W 1SS
520
W2N ---
510
W3S ---
478
N10W 2NN
468
S16W 1SS
545
S3E 1SS
543
E8S ---
539
N2EP 2SN
501
SX3WX 5SSX
475
N2EG 1NN
469
N2E 1NN
544
S20W 4NS
534
S1W 1SS
528
W1N 4SN
522
S1W 1SS
510
S1W 1SS
504
S2W 6NS
478
S5W 2SS
470
S1W 1SS
462
543
N11E 2NN
537
S3E 1SS
527
S14E 1NS
521
E5N 3SN
511
E3N ---
503
N3E
491
E1S ---
465
NP2E 2NNP
461
E8S
540
W15N
536
S4W 1SS
528
S23W 2SS
520
N3W 1NN
512
W3S 10NS
504
W2N
476
N19W 19EW
466
S2W 1SS
460
N12W
385
276
361
281
20
21
16
36
83
155
129
12
40
77
30
29
120
71
39
38

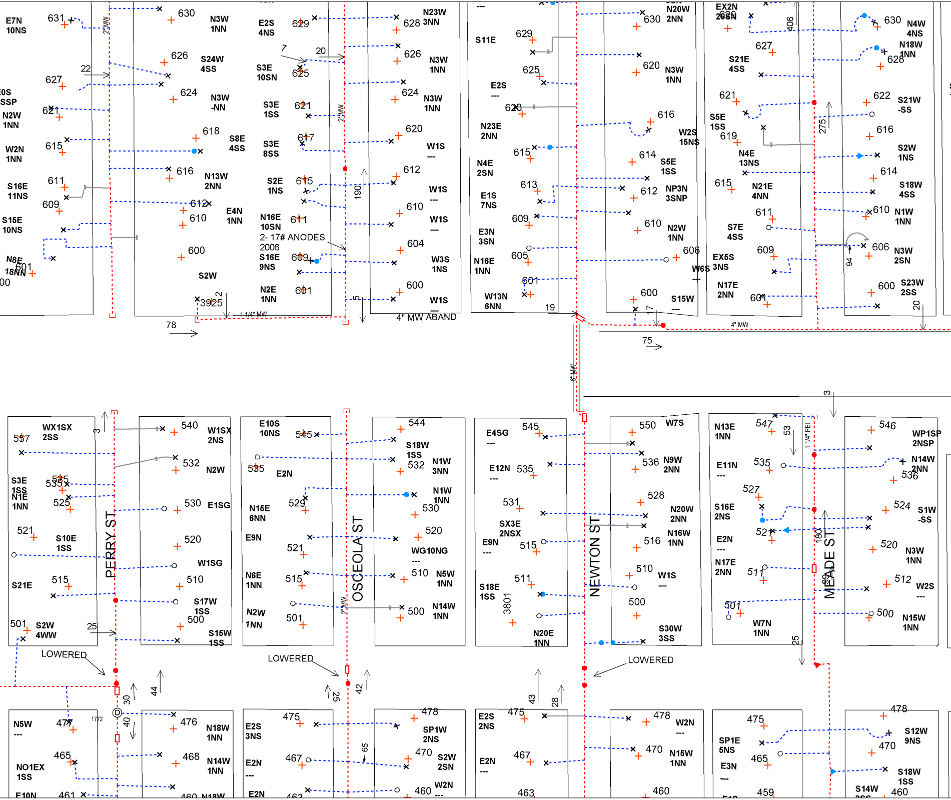
PERRY ST
OSCEOLA ST
NEWTON ST
MEADE ST
LOWERED
LOWERED
LOWERED
2- 17# ANODES
2006
4" MW ABAND
1 1/4" MW
2" MW
6" MW
4" MW
1 1/4" PEI
78
75
190
275
180

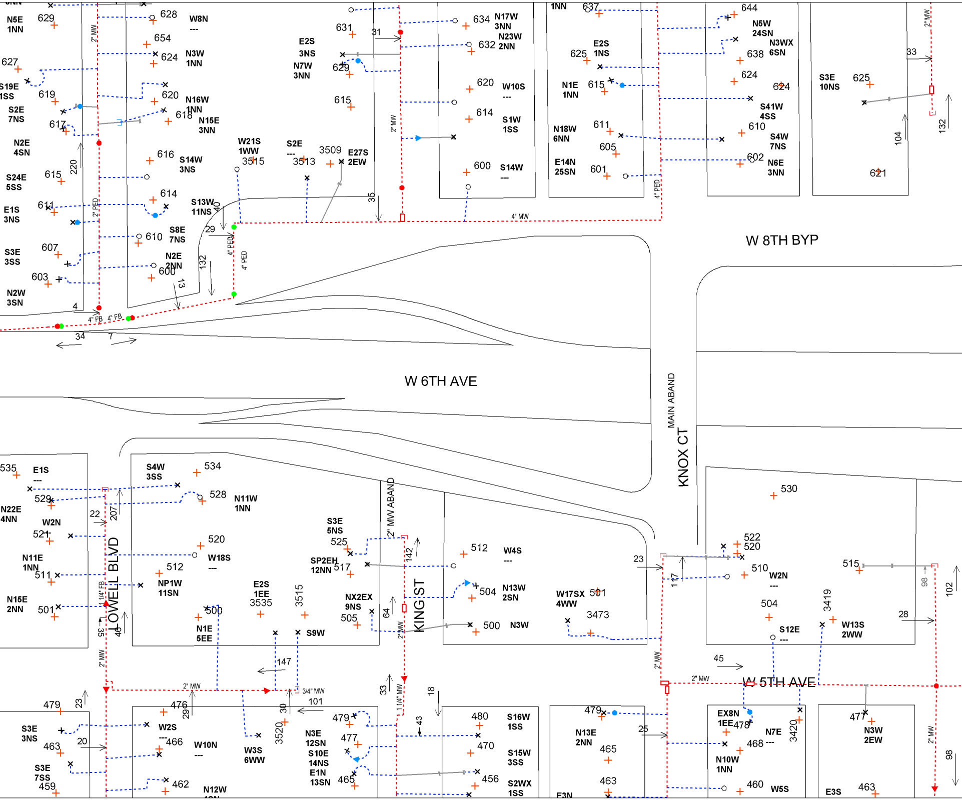
W 8TH BYP
W 6TH AVE
W 5TH AVE
LOWELL BLVD
KING ST
KNOX CT
MAIN ABAND
2" MW ABAND
4" MW
2" MW
1 1/4" MW
3/4" MW
4" PED
2" PED
4" FB
1/4" FB
629
628
654
624
627
619
620
618
617
616
615
614
611
610
607
603
600
631
634
632
625
637
644
638
602
601
605
621
3509
3515
3513
535
534
528
529
521
520
512
511
501
500
525
517
505
504
530
522
515
510
3535
3473
3419
3420
3520
479
476
466
463
462
459
480
477
470
465
456
478
468
460
N5E 1NN
W8N
N3W 1NN
N16W 1NN
N15E 3NN
S14W 3NS
S13W 11NS
S8E 7NS
N2E 2NN
E2S 3NS
N7W 3NN
W21S 1WW
S2E
E27S 2EW
N17W 3NN
N23W 2NN
W10S
S1W 1SS
S14W
E2S 1NS
N1E 1NN
N18W 6NN
E14N 25SN
N5W 24SN
N3WX 6SN
S41W 4SS
S4W 7NS
N6E 3NN
S3E 10NS
S19E 1SS
S2E 7NS
N2E 4SN
S24E 5SS
E1S 3NS
S3E 3SS
N2W 3SN
E1S
N22E 4NN
W2N
N11E 1NN
N15E 2NN
S4W 3SS
N11W 1NN
W18S
NP1W 11SN
E2S 1EE
N1E 5EE
S9W
S3E 5NS
SP2EH 12NN
NX2EX 9NS
W4S
N13W 2SN
N3W
W17SX 4WW
W2N
S12E
W13S 2WW
S3E 3NS
S3E 7SS
W2S
W10N
W3S 6WW
N12W
N3E 12SN
S10E 14NS
E1N 13SN
S16W 1SS
S15W 3SS
S2WX 1SS
N13E 2NN
E3N
EX8N 1EE
N7E
N10W 1NN
W5S
N3W 2EW
E3S
220
132
104
35
31
33
40
29
13
34
7
4
22
207
142
64
147
101
43
18
23
25
45
28
98
102
117
20
30

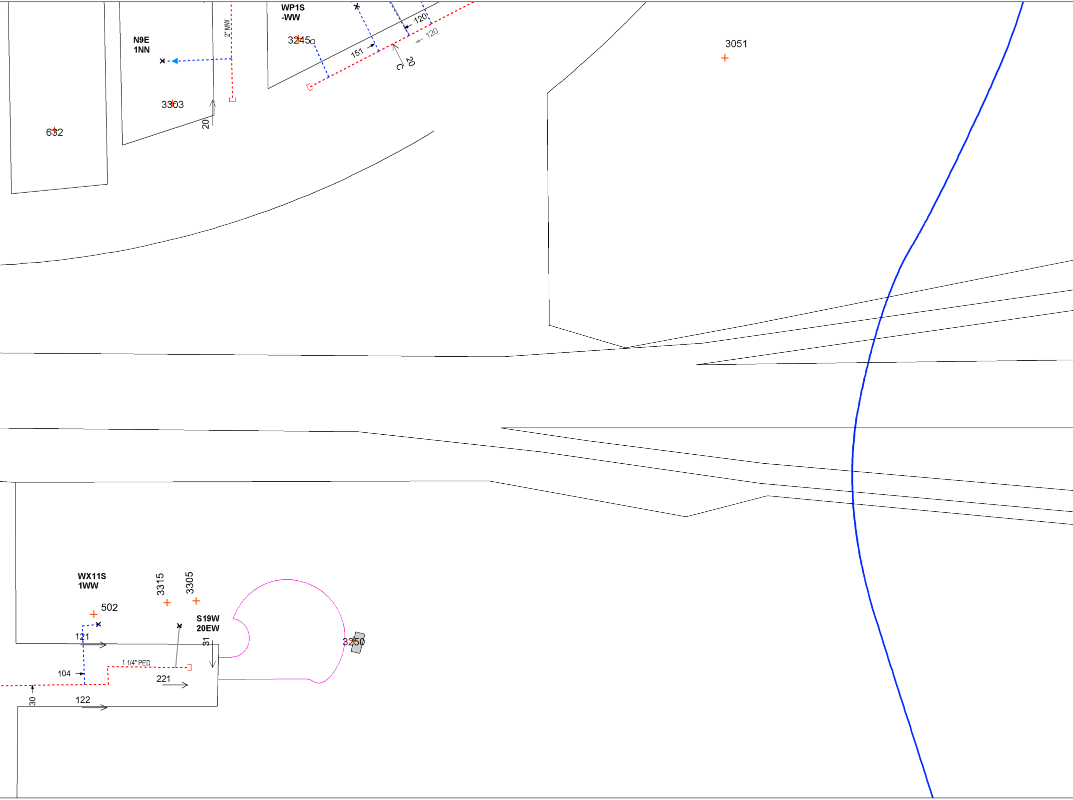
WP1S
-WW
3245
151
120
120
C
20
N9E
1NN
2" MW
3303
20
632
3051
WX11S
1WW
502
3315
3305
S19W
20EW
31
121
3250
1 1/4" PED
104
221
30
122

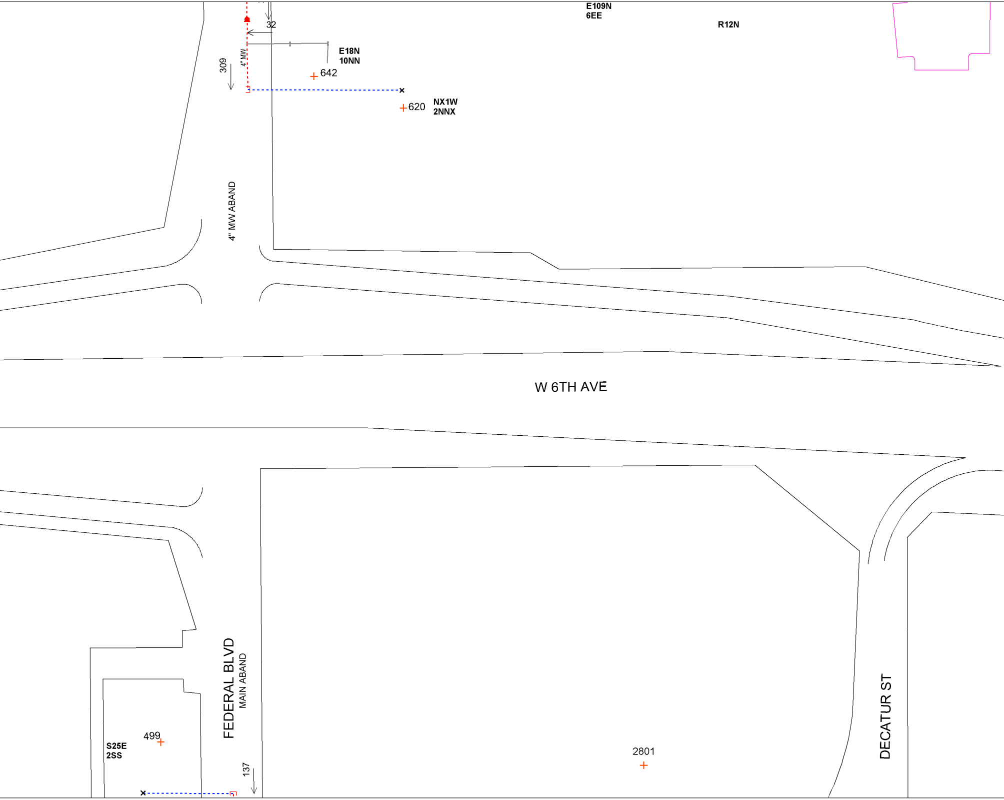
E109N
6EE
R12N
32
E18N
10NN
309
4" MW
642
620
NX1W
2NNX
4" MW ABAND
W 6TH AVE
FEDERAL BLVD
MAIN ABAND
DECATUR ST
499
S25E
2SS
137
2801

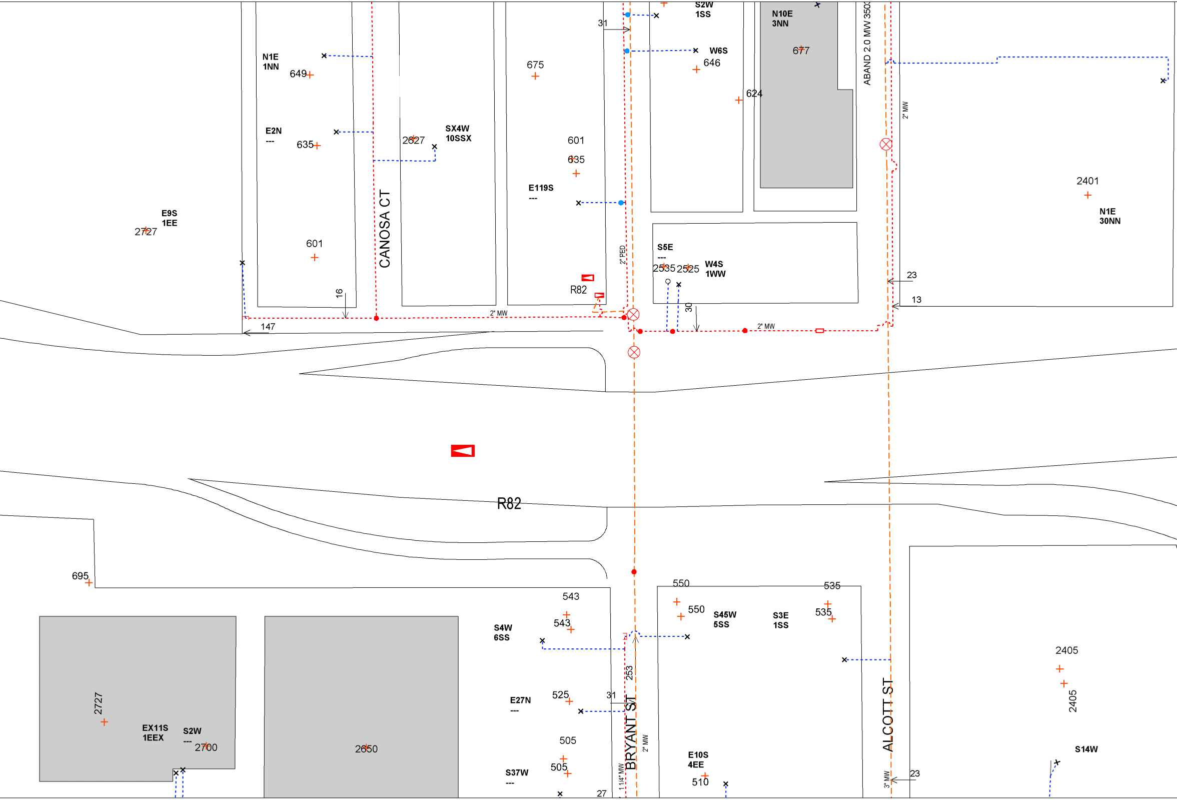

N1E
1NN
649
E2N

635
E9S
1EE
2727
601
16
CANOSA CT
2627
SX4W
10SSX
675
601
635
E119S

R82
2" MW
147
31
2" PED
S2W
1SS
W6S
646
624
N10E
3NN
677
ABAND 2.0 MW 350
2" MW
S5E

2535
2525
W4S
1WW
30
2" MW
2401
N1E
30NN
23
13
R82
695
543
543
S4W
6SS
550
550
S45W
5SS
S3E
1SS
535
535
253
E27N

525
31
505
505
S37W

27
1 1/4" MW
BRYANT ST
2" MW
E10S
4EE
510
ALCOTT ST
3" MW
23
2405
2405
S14W
2727
EX11S
1EEX
S2W

2700
2650

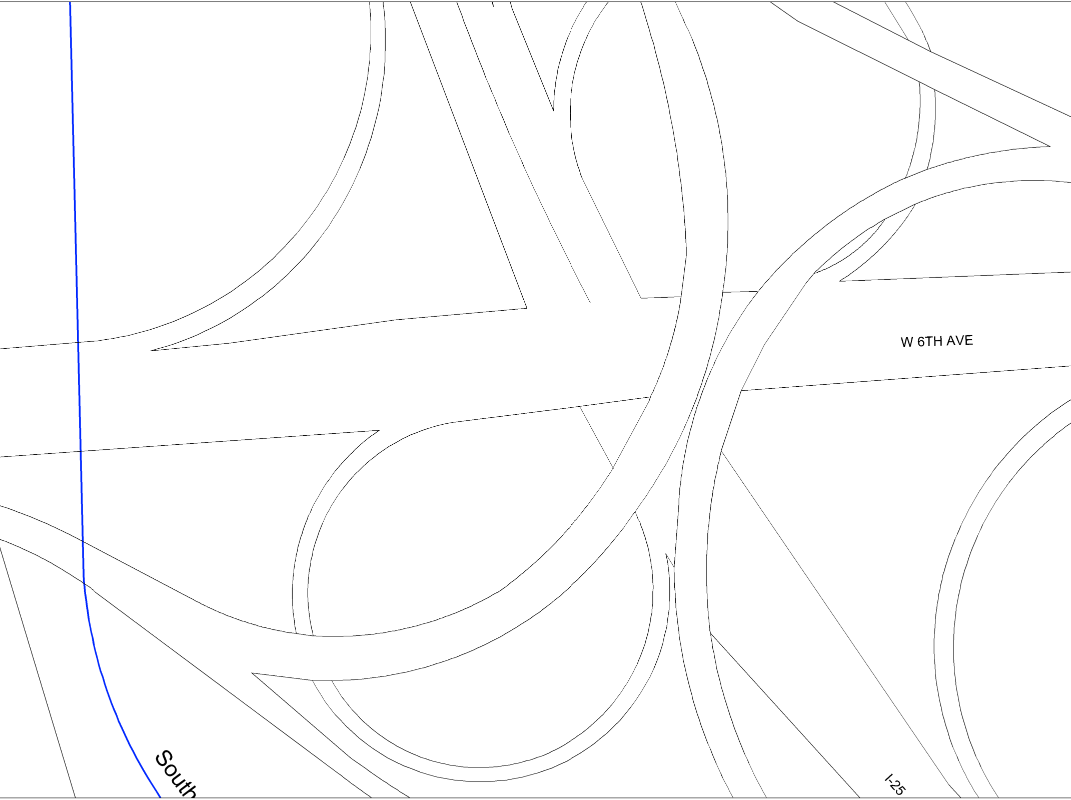
W 6TH AVE
I-25
South

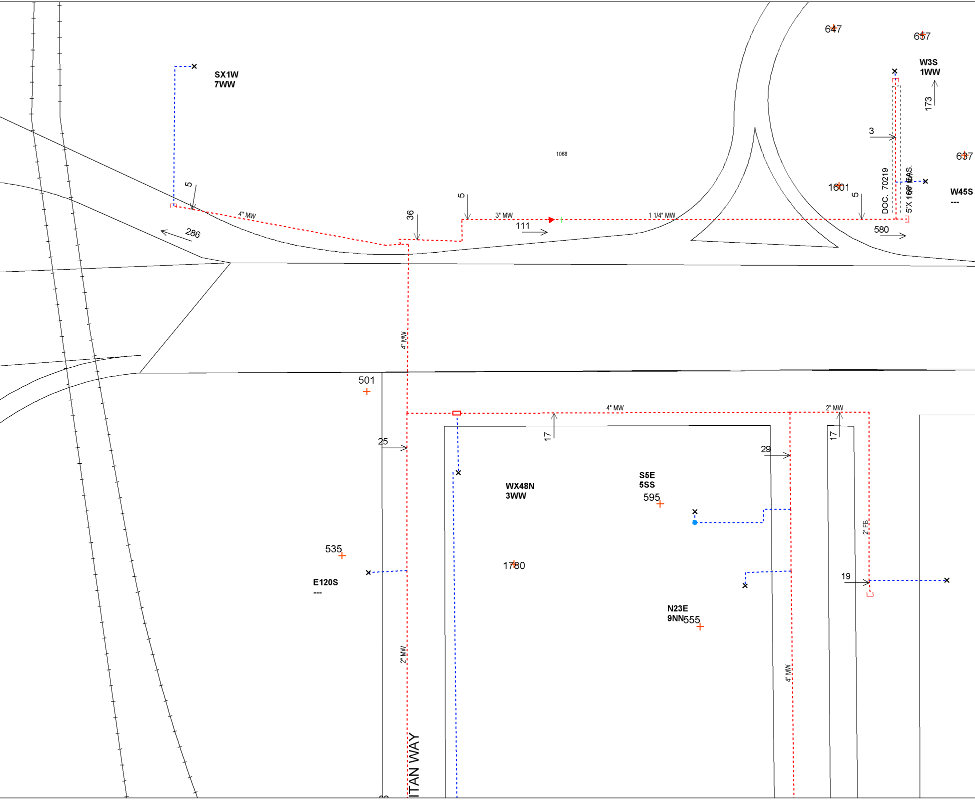
647
657
W3S
1WW
173
SX1W
7WW
3
1068
637
DOC. 70219
5'X 160' EAS.
1601
W45S

5
5
4" MW
286
36
5
3" MW
111
1 1/4" MW
5
580
4" MW
501
4" MW
2" MW
25
17
17
29
WX48N
3WW
S5E
5SS
595
2" FB
535
E120S

1780
19
N23E
9NN
555
2" MW
4" MW
ITAN WAY

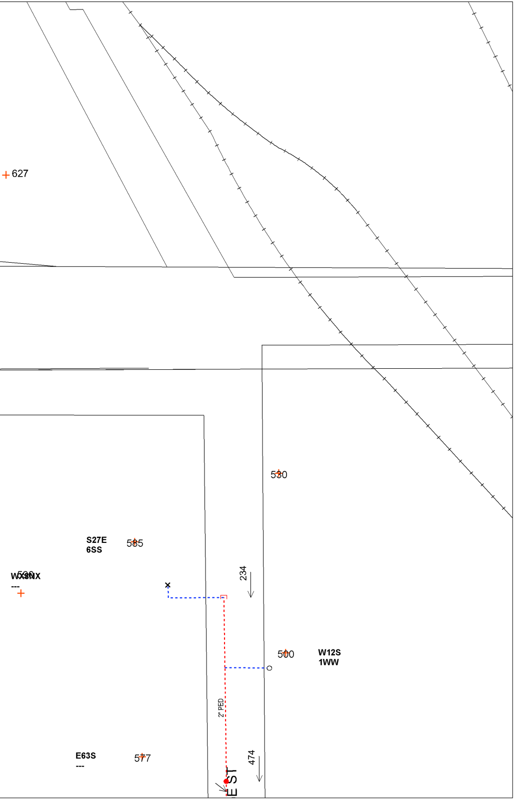
627
530
S27E
6SS
585
WX8NX
590

234
500
W12S
1WW
2" PED
E63S

577
474
E ST