

NOTE:
 1. O/S ARE TAKEN FROM EAST EOP
 OF OSAGE ST

DENVER COUNTY
 SEC 9
 T 4S R 68W



1200 Landmark Center,
 Suite 1300
 Omaha, Nebraska 68102

Project Office:
 6275 Joyce Drive
 Golden, Colorado 80403-7541

PROJECT NO.:
 902059

COLORADO DEPARTMENT
 OF TRANSPORTATION
 BACKBONE 2
 SECTION 2


CLARIFICATION NO.	QUANTITY

REVISION STATUS		
DATE	BY	DESCRIPTION

ORIGIN, BY:
 DATE OF ORIGIN:
 DRAWN BY: JLS
 DATE DRAWN: 5/9/02
 APPVD BY:
 DATE APPVD:
 FINAL APPROVAL:

**** NOTICE ****
 INFORMATION ON THIS
 DOCUMENT IS PROPRIETARY
 AND SHALL NOT BE USED,
 COPIED, REPRODUCED OR
 DISCLOSED IN WHOLE OR
 IN PART WITHOUT WRITTEN
 CONSENT OF ADESTA

CAD FILENAME: 082SEC2189
 SHEET: 189 OF: 229
 SCALE: NOT TO SCALE

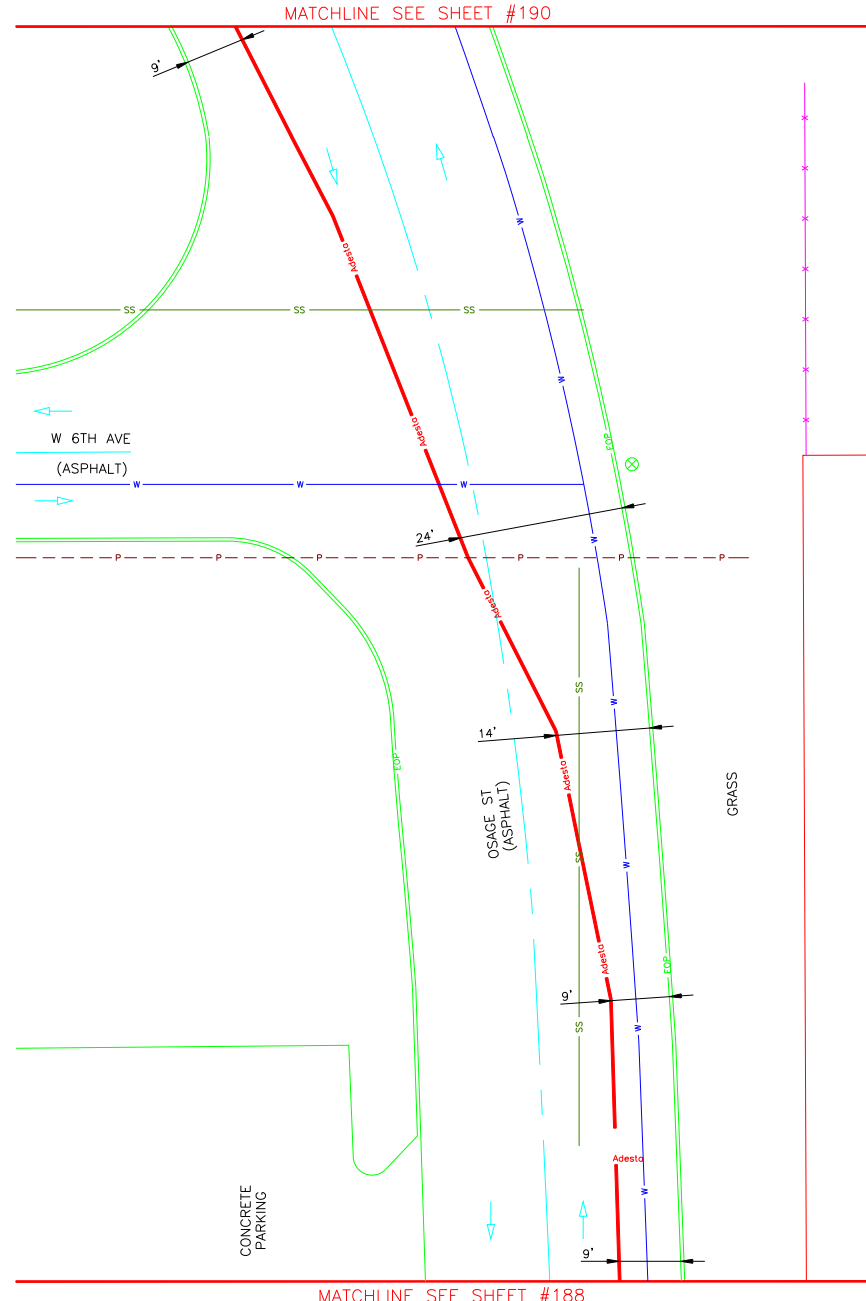

STA: 385+08 MATCHLINE

STA: 385+00 R/L (174")

STA: 384+66 12" SS LINE (117"), R/L (182")

STA: 384+43 PWR POLE O/S 4'

STA: 384+40 10" WTR LINE (55"), R/L (199")

STA: 384+29 6" PVC LINE (40"), R/L (196")

STA: 384+00 R/L (192")

STA: 383+83 12" SS LINE (113"), R/L (174")

STA: 383+60 R/L (150")

STA: 383+30 R/L (133")

STA: 383+18 MATCHLINE

MATCHLINE SEE SHEET #190

MATCHLINE SEE SHEET #188