

NOTE:
1. O/S ARE TAKEN FROM WEST EOP OF OSAGE ST

DENVER COUNTY
SEC 4
T 4S R 68W



1200 Landmark Center,
Suite 1300
Omaha, Nebraska 68102

Project Office:
6275 Joyce Drive
Golden, Colorado 80403-7541

PROJECT NO.:
902059

COLORADO DEPARTMENT
OF TRANSPORTATION
BACKBONE 2
SECTION 2

CLARIFICATION NO. QUANTITY

CLARIFICATION NO.	QUANTITY

REVISION STATUS

DATE	BY	DESCRIPTION

ORIGIN. BY:

DATE OF ORIGIN:

DRAWN BY: JLS

DATE DRAWN: 5/9/02

APPVD BY:

DATE APPVD:

FINAL APPROVAL:


**** NOTICE ****

INFORMATION ON THIS DOCUMENT IS PROPRIETARY AND SHALL NOT BE USED, COPIED, REPRODUCED OR DISCLOSED IN WHOLE OR IN PART WITHOUT WRITTEN CONSENT OF ADESTA

CAD FILENAME: B82SEC2190

SHEET: 190 OF 229

SCALE: NOT TO SCALE

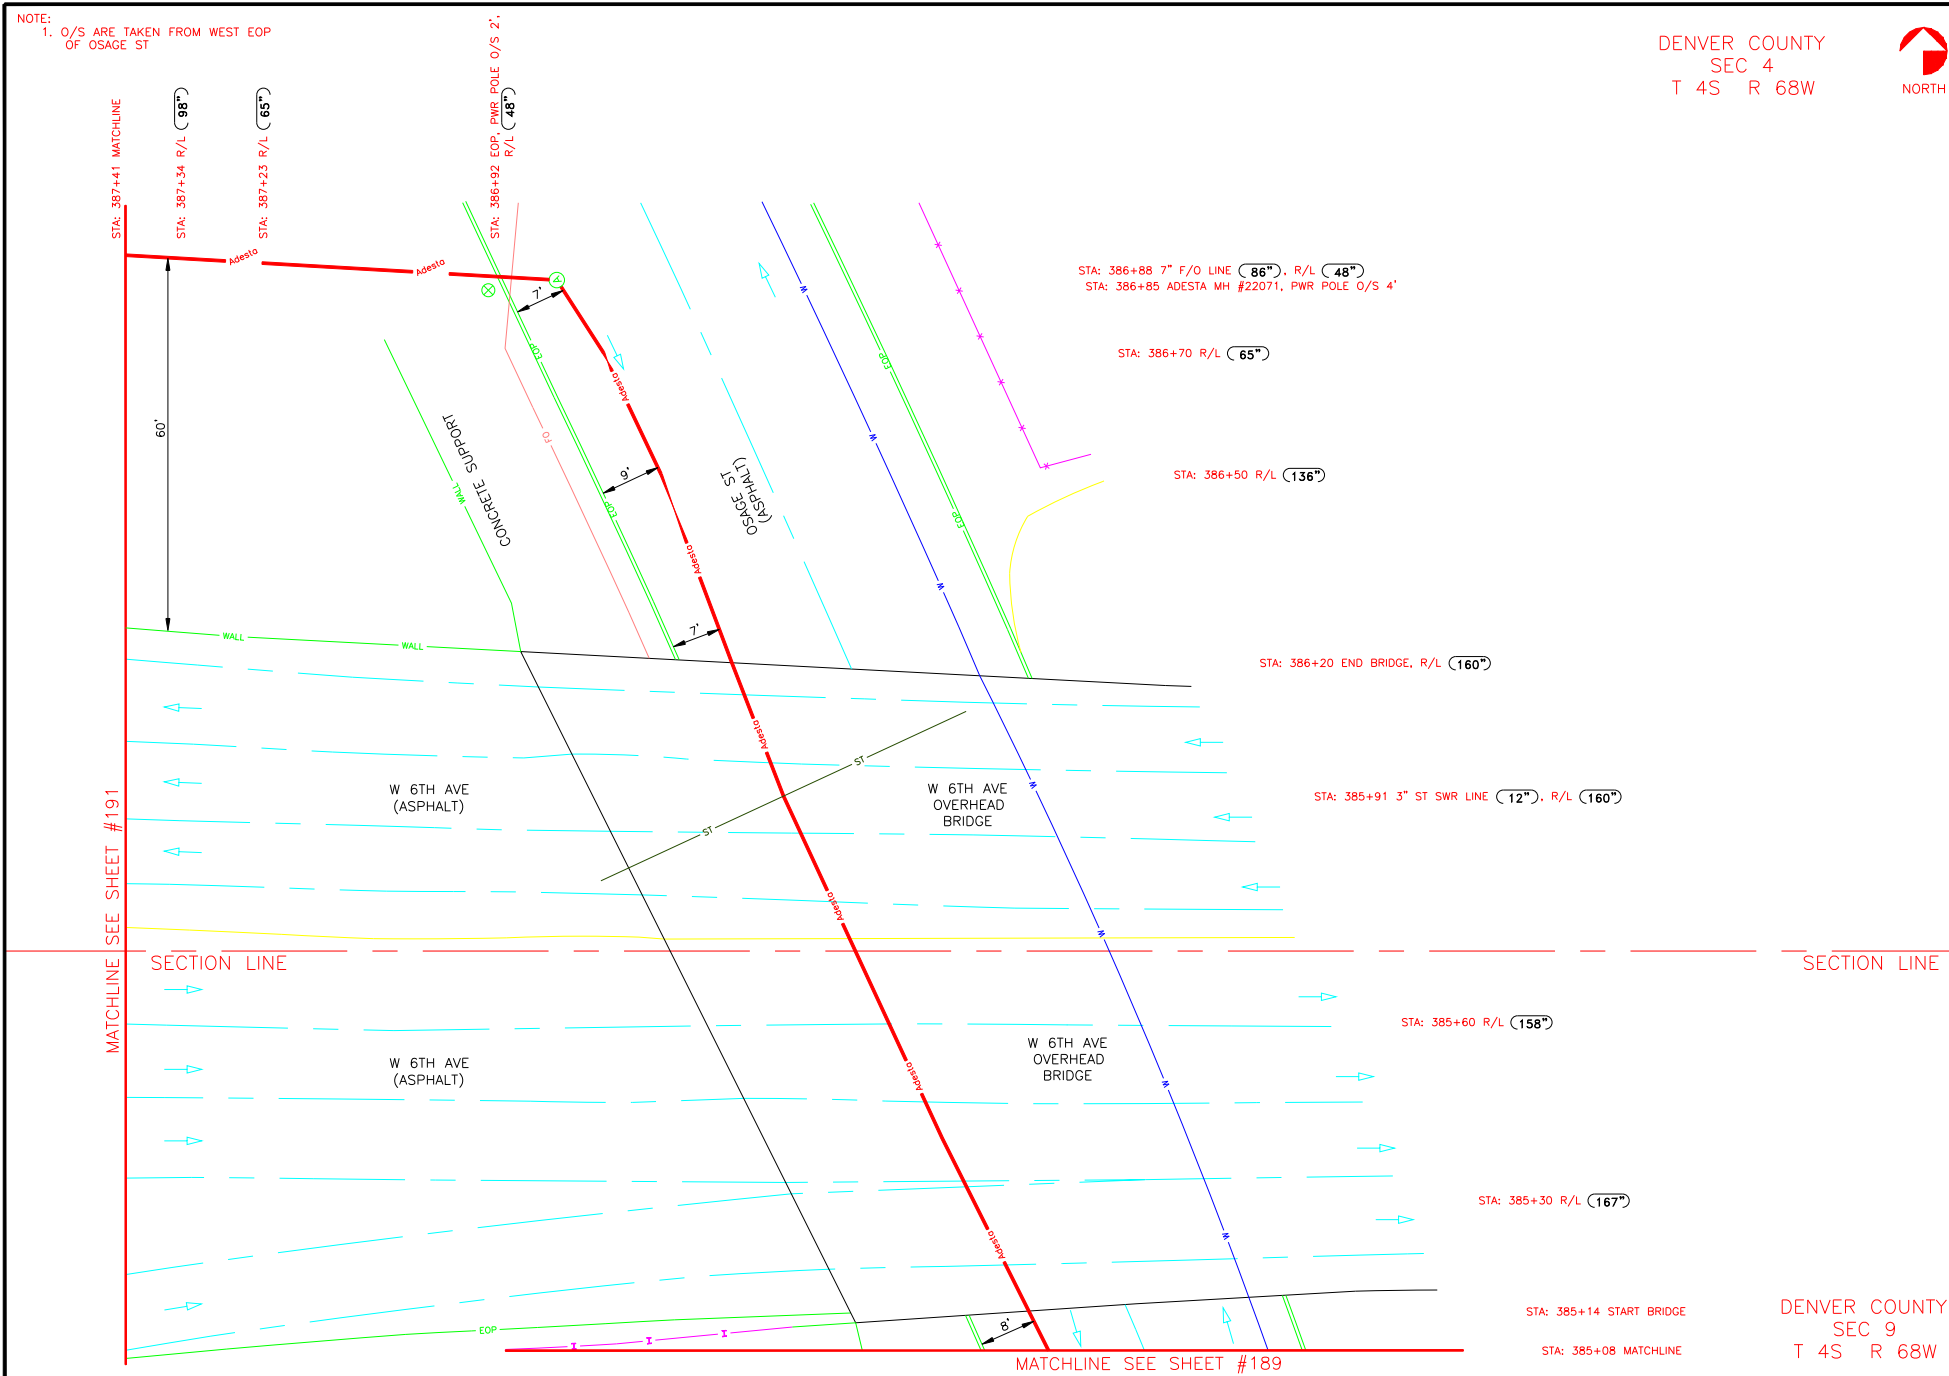

DENVER COUNTY
SEC 9
T 4S R 68W