

NOTE:
1. O/S ARE TAKEN FROM NORTH EOP
OF W 6TH AVE

DENVER COUNTY
SEC 4
T 4S R 68W



1200 Landmark Center,
Suite 1300
Omaha, Nebraska 68102

Project Office:
6275 Joyce Drive
Golden, Colorado 80403-7541

PROJECT NO.:
902059

COLORADO DEPARTMENT
OF TRANSPORTATION


BACKBONE 2
SECTION 2

CLARIFICATION NO.	QUANTITY

REVISION STATUS		
DATE	BY	DESCRIPTION

**** NOTICE ****
INFORMATION ON THIS DOCUMENT IS PROPRIETARY AND SHALL NOT BE USED, COPIED, REPRODUCED OR DISCLOSED IN WHOLE OR IN PART WITHOUT WRITTEN CONSENT OF ADESTA

CAD FILENAME: 0825SEC2191
SHEET: 191 OF: 229
SCALE: NOT TO SCALE

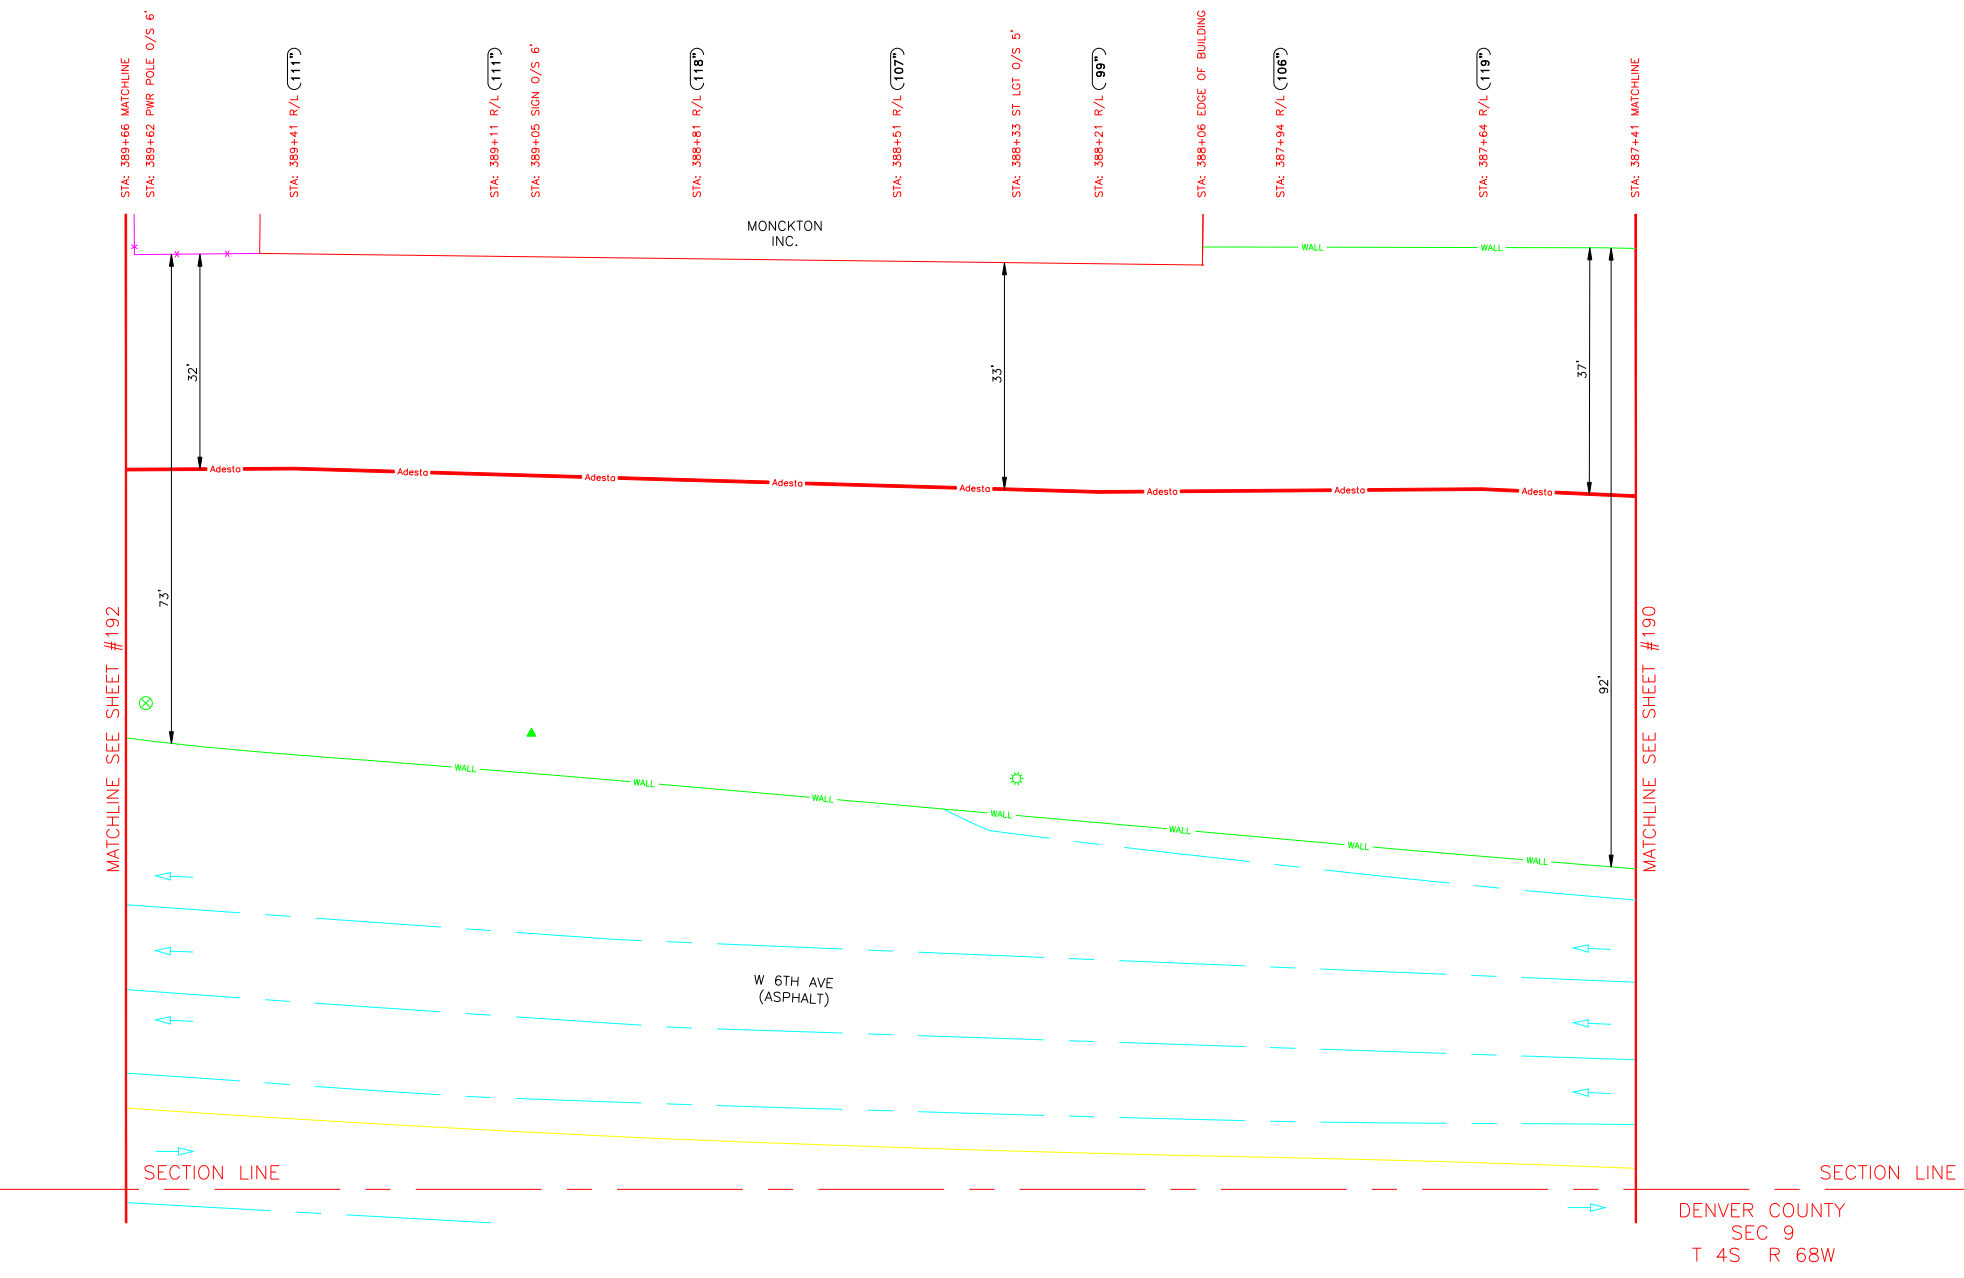

DENVER COUNTY
SEC 9
T 4S R 68W