

NOTE:  
1. O/S ARE TAKEN FROM NORTH EOP  
OF W 6TH AVE

DENVER COUNTY  
SEC 4  
T 4S R 68W



1200 Landmark Center,  
Suite 1300  
Omaha, Nebraska 68102

Project Office:  
6275 Joyce Drive  
Golden, Colorado 80403-7541

PROJECT NO.:  
902059

COLORADO DEPARTMENT  
OF TRANSPORTATION  
BACKBONE 2  
SECTION 2

CLARIFICATION NO.	QUANTITY

REVISION STATUS		
DATE	BY	DESCRIPTION

ORIGIN, BY:  
DATE OF ORIGIN:  
DRAWN BY: JLS  
DATE DRAWN: 5/9/02  
APPVD BY:  
DATE APPVD:  
FINAL APPROVAL:

\*\*\*\* NOTICE \*\*\*\*  
INFORMATION ON THIS  
DOCUMENT IS PROPRIETARY  
AND SHALL NOT BE USED,  
COPIED, REPRODUCED OR  
DISCLOSED IN WHOLE OR  
IN PART WITHOUT WRITTEN  
CONSENT OF ADESTA


CAD FILENAME: B82SEC2192  
SHEET: 192 OF: 229  
SCALE: NOT TO SCALE

MATCHLINE SEE SHEET #193

MATCHLINE SEE SHEET #191

SECTION LINE

SECTION LINE

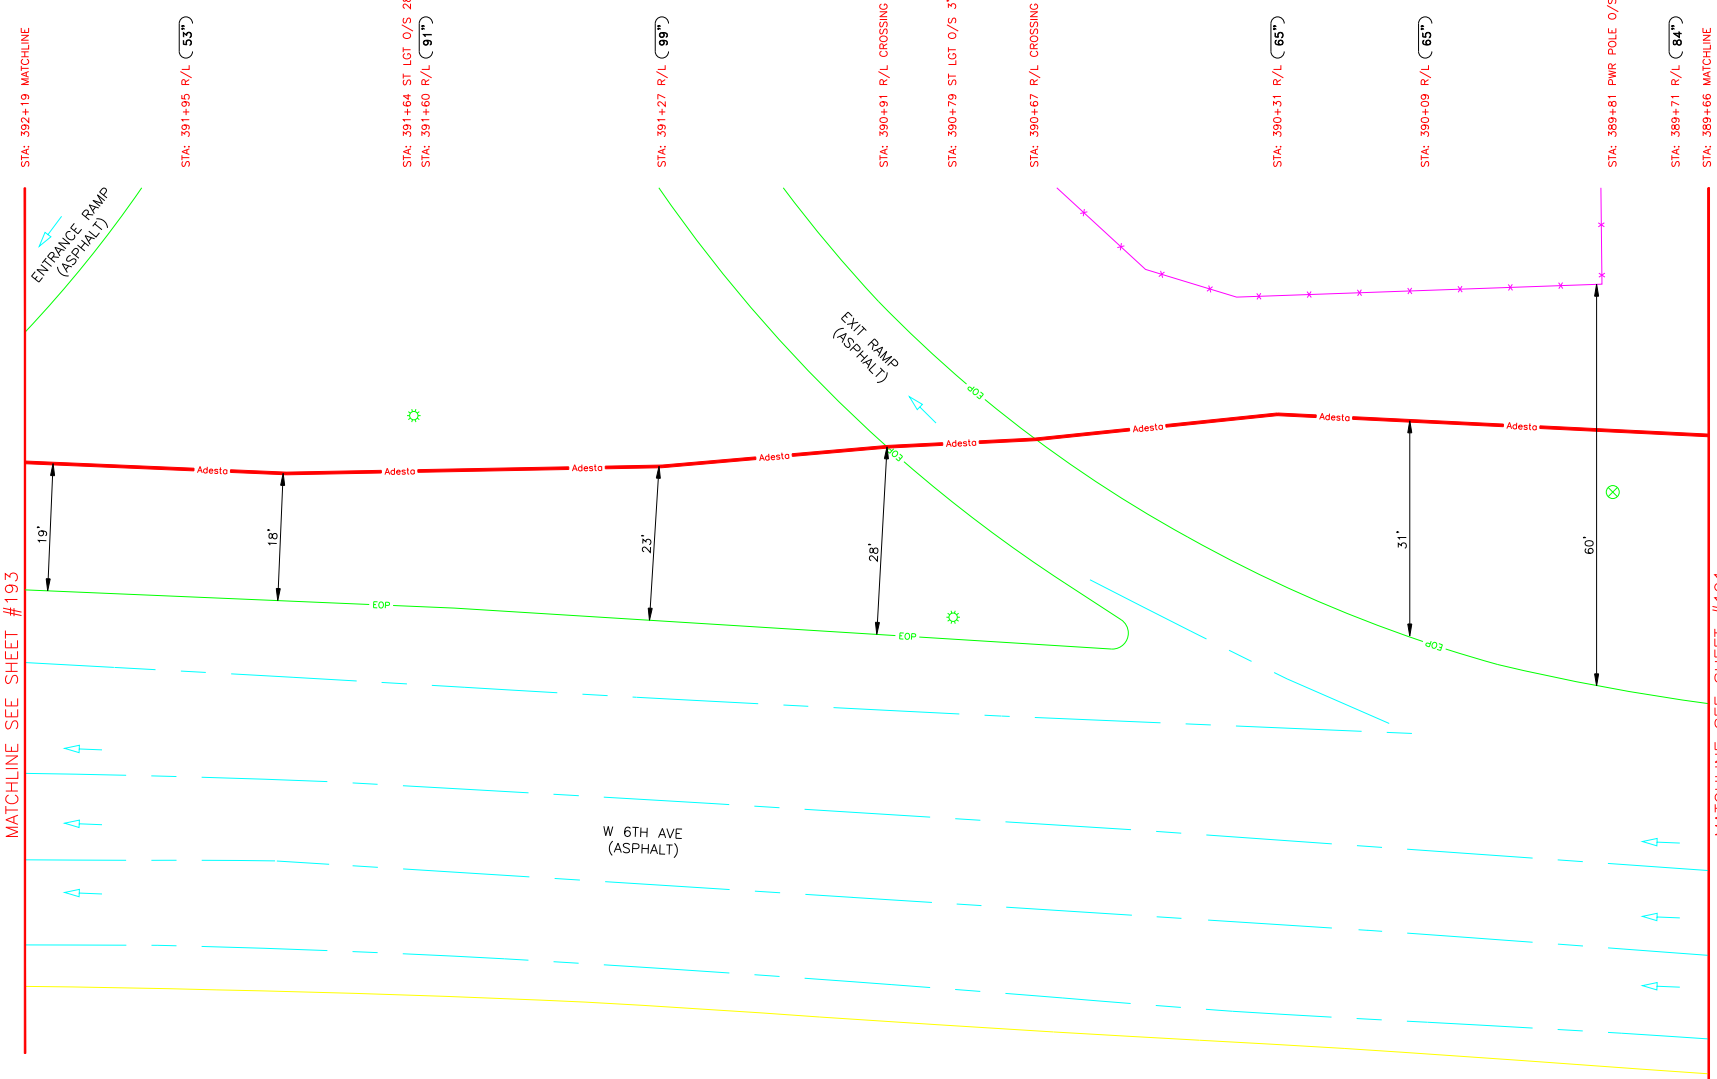

DENVER COUNTY  
SEC 9  
T 4S R 68W