NOTE:
1. O/S ARE TAKEN FROM NORTH EOP OF W 6TH AVE

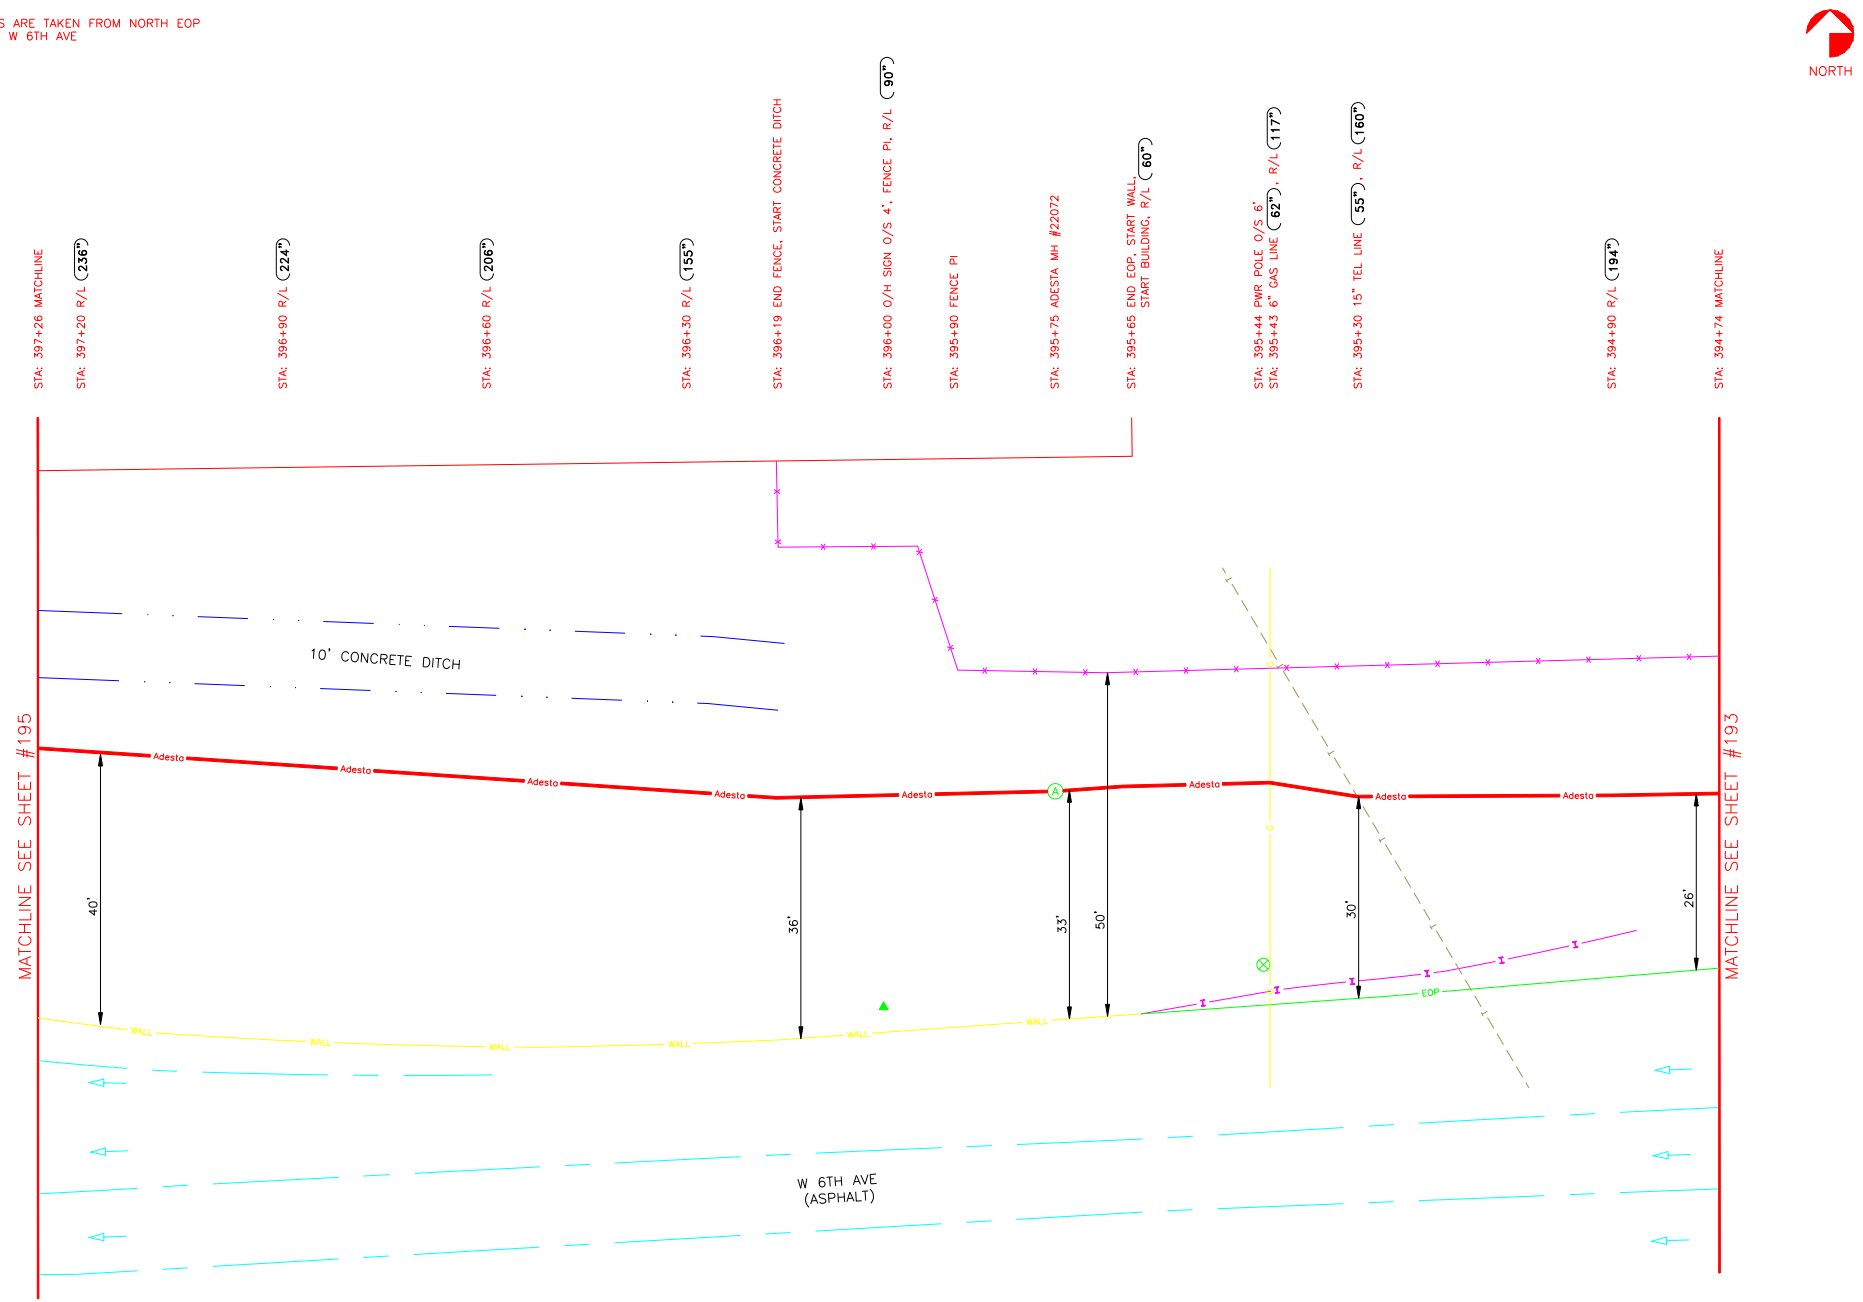

ADESTA Communications
1200 Landmark Center, Suite 1300
Omaha, Nebraska 68102

Project Office:
6275 Joyce Drive
Golden, Colorado 80403-7541

PROJECT NO.:
902059

COLORADO DEPARTMENT OF TRANSPORTATION

BACKBONE 2
SECTION 2

CLARIFICATION NO.	QUANTITY

REVISION STATUS

DATE	BY	DESCRIPTION

ORIGIN. BY:	
DATE OF ORIGIN:	
DRAWN BY:	JLS
DATE DRAWN:	5/9/02
APPVD BY:	
DATE APPVD:	
FINAL APPROVAL:	

**** NOTICE ****
INFORMATION ON THIS DOCUMENT IS PROPRIETARY AND SHALL NOT BE USED, COPIED, REPRODUCED OR DISCLOSED IN WHOLE OR IN PART WITHOUT WRITTEN CONSENT OF ADESTA

CAD FILENAME: BB2SEC2194
SHEET: 194 OF: 229
SCALE: NOT TO SCALE