


I-25 and Arapahoe Road Interchange Operational Improvements

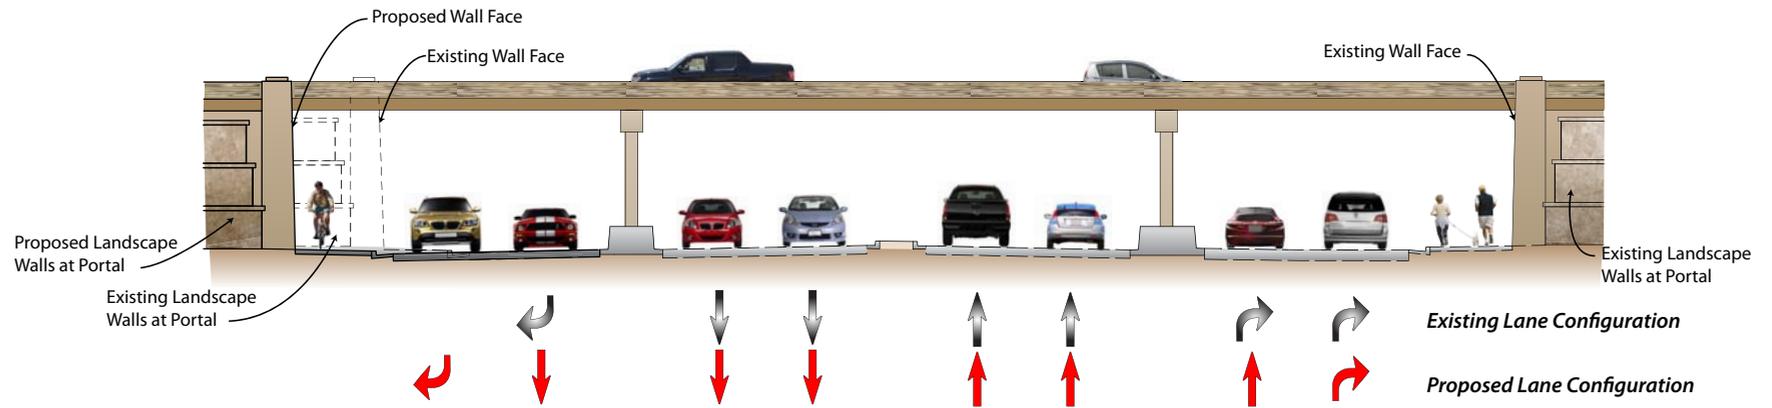

Arapahoe Road Under I-25
(Cross Section Looking East)