


PROJECT I-70-3(2) 251 UNIT 2  
 IDAHO SPRINGS TUNNELS  
 GEOLOGIC LOG OF THE PIONEER BORE  
 STATION 172 + 40 — 180 + 25

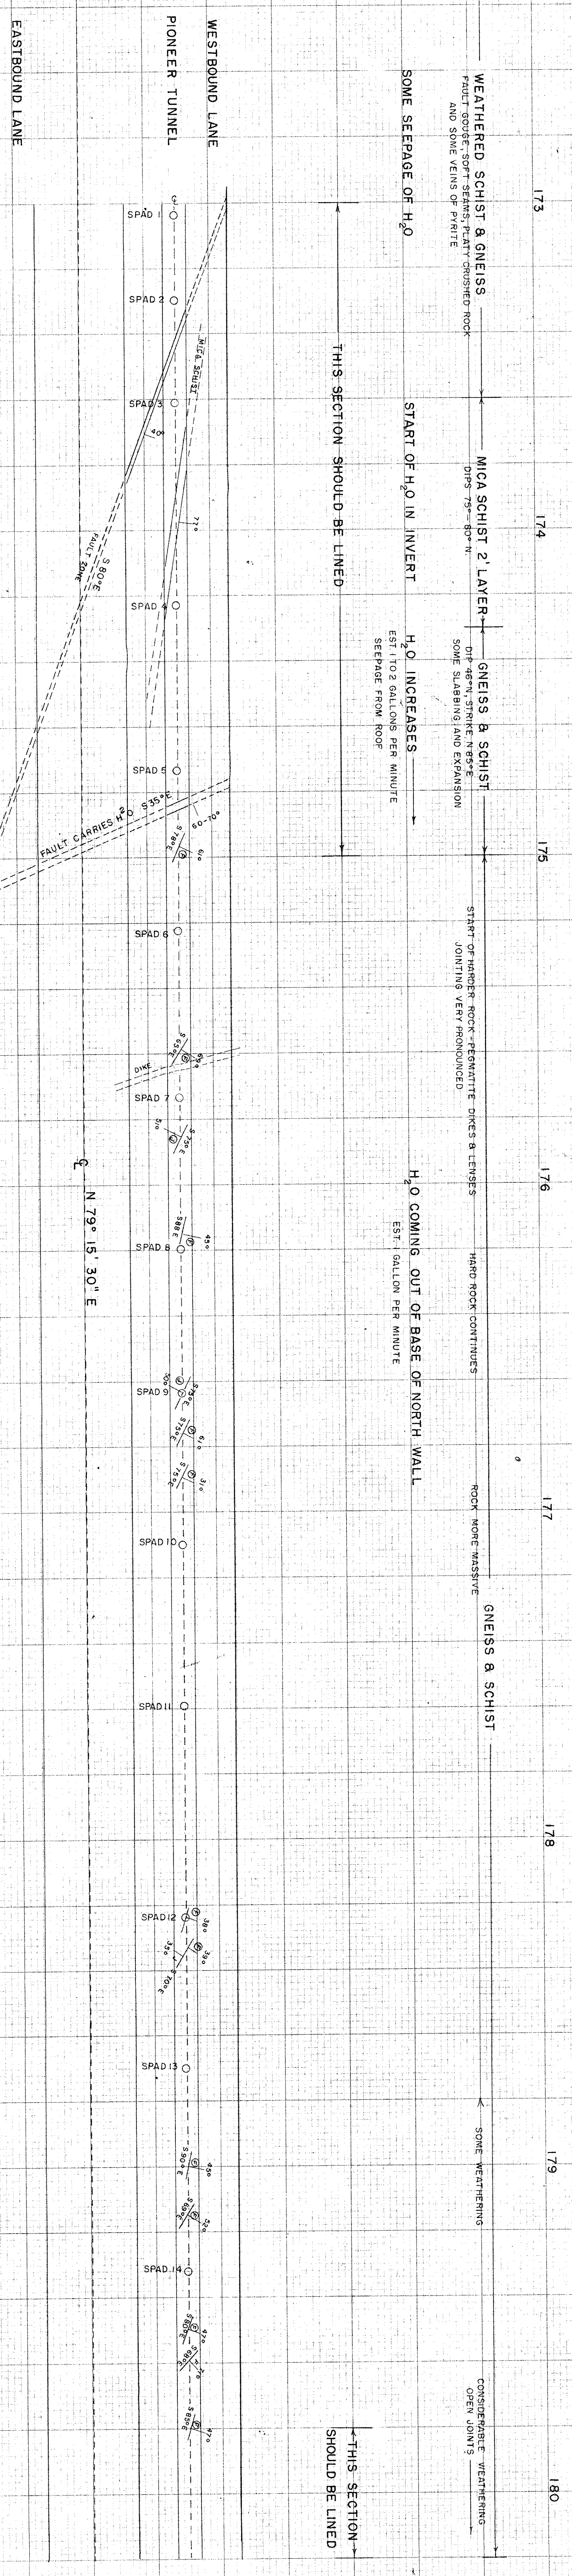

SCALE = 1" = 20' HORIZONTAL  
 " = 20' VERTICAL  
 F = FOLIATION DIP  
 J = JOINT DIP

