Gneiss

Weathered Gneiss

Weathered Gneiss,
oxidized

Quartz Pegmatite

Measured Dip/Dip Direction

Apparent
Dip/Dip Direction
(from photo)

Apparent Plunging
Shear Plane

Apparent Upward Foliation

Apparent Downward Foliation

Apparent Horizontal Foliation

Blocky habit

TT-2 As Built TT Rock Types

PRELIMINARY

FOR INFORMATION ONLY

Yeh and Associates, Inc.
Consulting Engineers & Scientists

Print Date: 11/8/2013		Sheet Revisions			Colorado Department of Transportation	As Constructed
File Name: I-70 WB Tunnel MApping Legend.dgn		Date:	Comments	Init.	425 A Corporate Circle	No Revisions:
Horiz. Scale: Vert. Scale:					Golden, CO 80401	Revised:
ATKINS 4601 DTC Boulevard, Suite 700 Denver, CO 80237 Phone: (303) 221-7275 Fax: (303) 221-7276					Phone: 720-497-6905 FAX: 720-497-6901	Void:
					Region 1 CRC	

GEOLOGY MAPPING LEGEND			Project No./Code
Designer: H. Hume	Structure Numbers		
Detailer: M. Walz			
Subset:	Subset Sheets: of		Sheet Number

Mike Walz 4:52:17 PM c:\pw_work\pbsjpw1\common\dms2337011-70 WB Tunnel MApping Legend.dgn

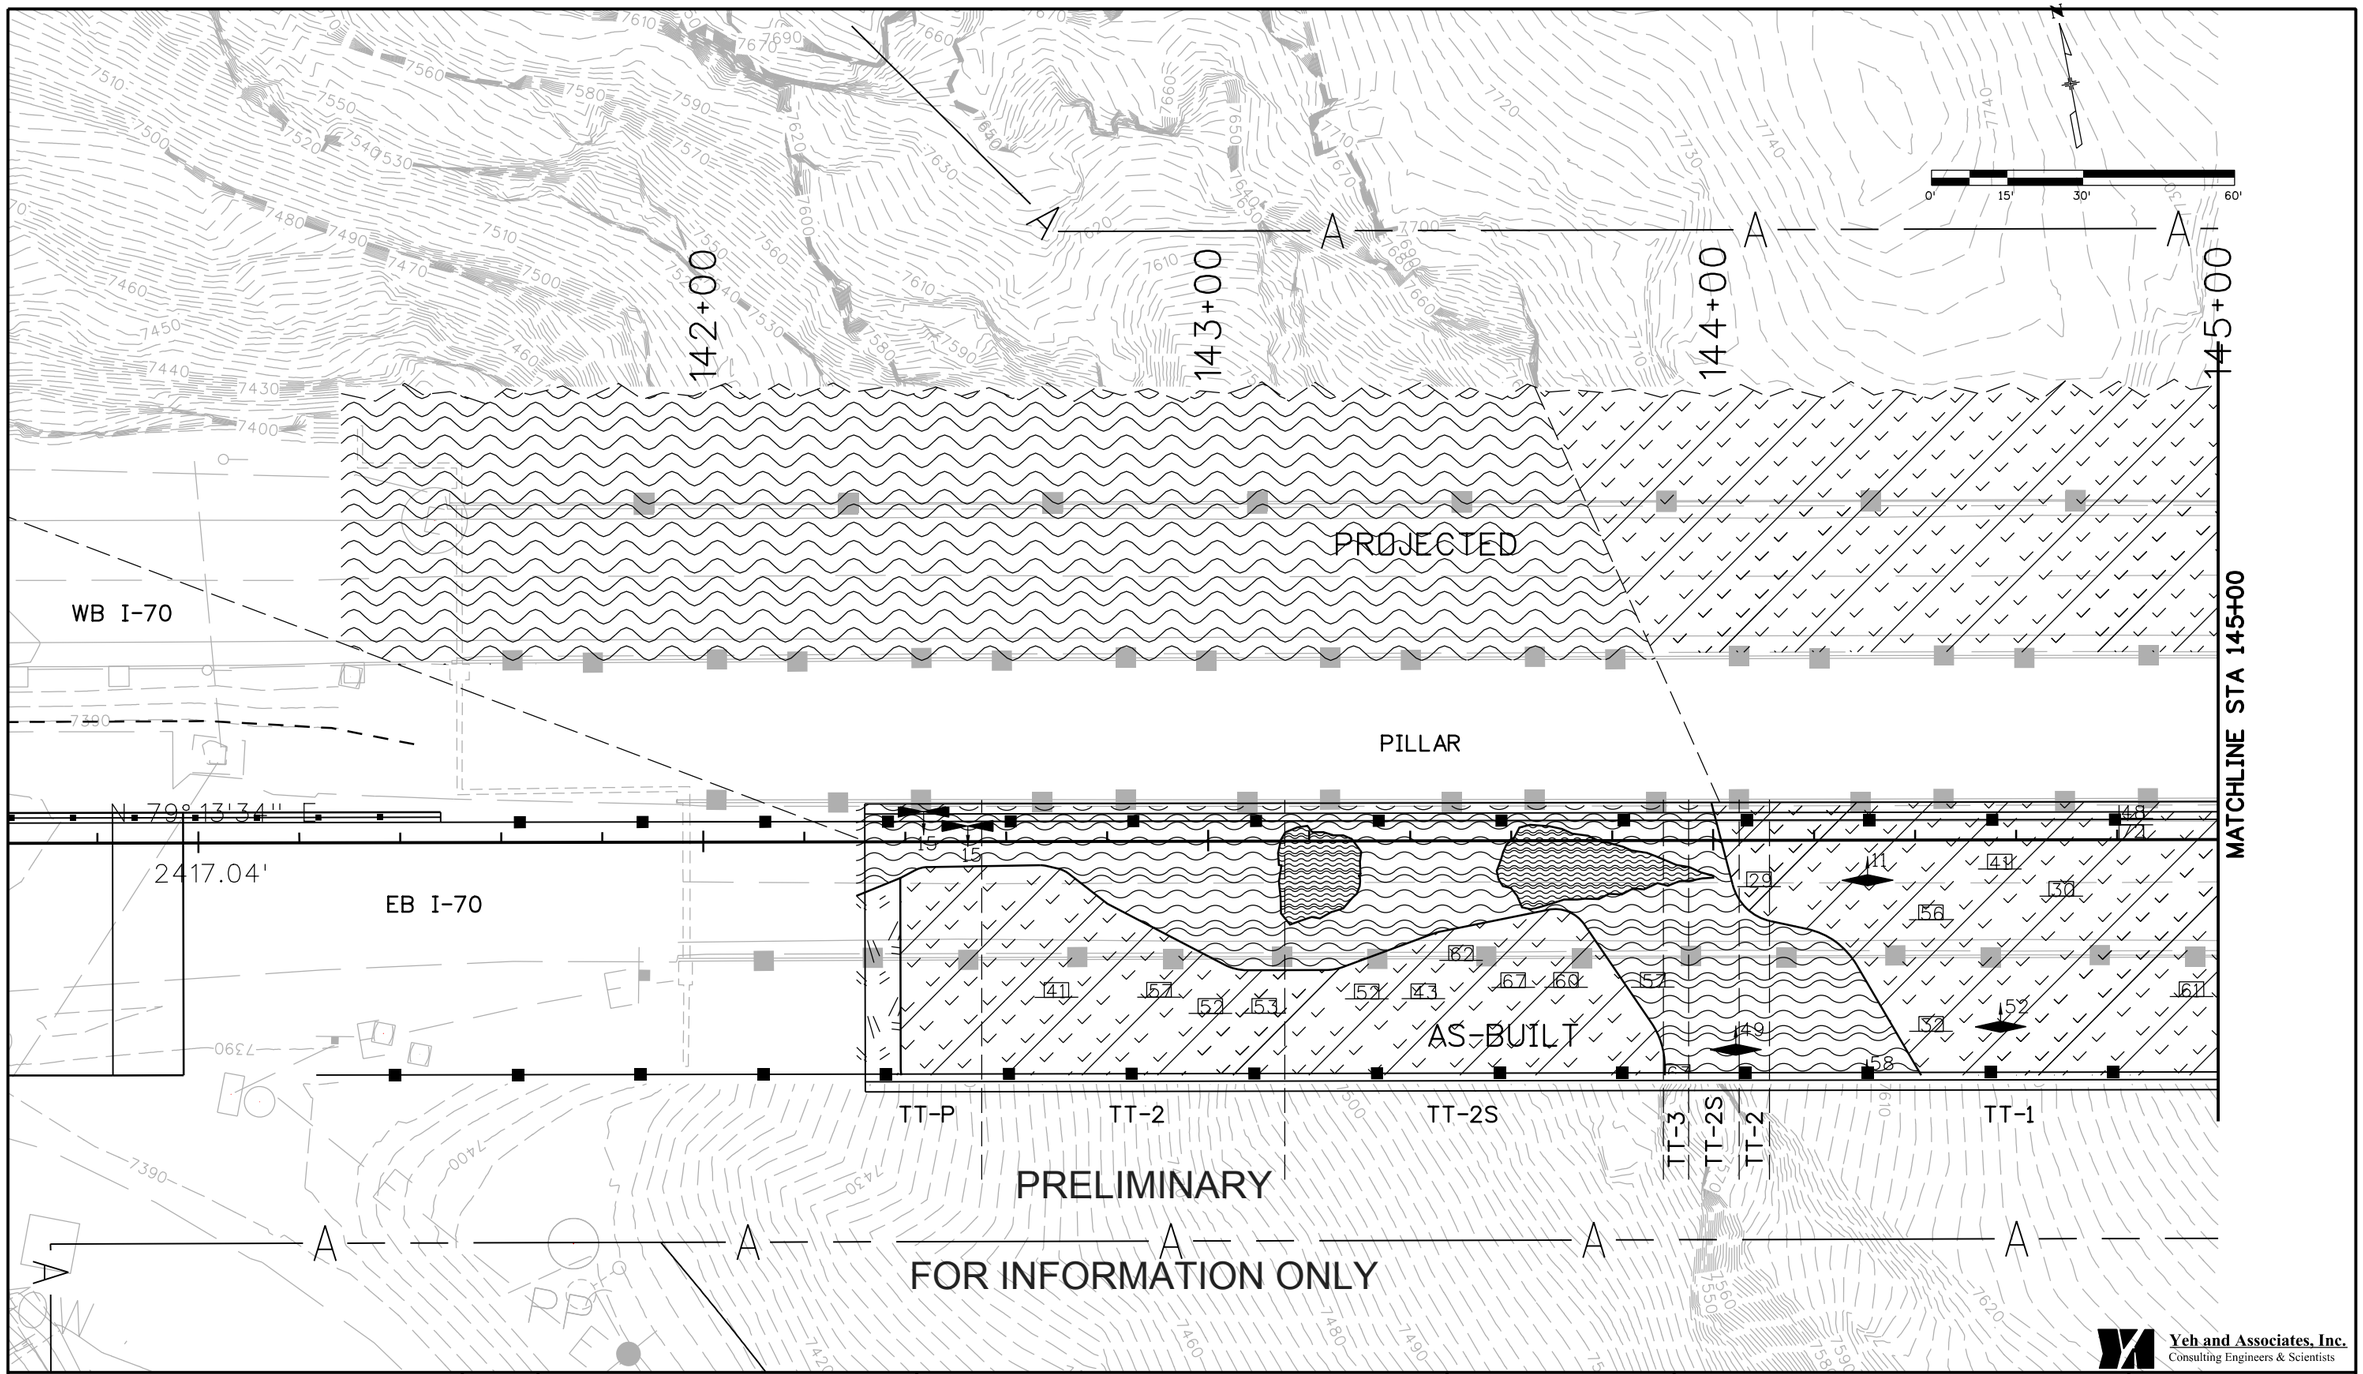

Yeh and Associates, Inc.
Consulting Engineers & Scientists

Print Date: 11/8/2013	Sheet Revisions	Colorado Department of Transportation	As Constructed
File Name: I-70 WB Tunnel Mapping01.dgn	Date: Comments Init.	425 A Corporate Circle	No Revisions:
Horiz. Scale: Vert. Scale:		Golden, CO 80401	Revised:
ATKINS 4601 DTC Boulevard, Suite 700 Denver, CO 80237 Phone: (303) 221-7275 Fax: (303) 221-7276		Phone: 720-497-6905 FAX: 720-497-6901	Void:
		Region 1 CRC	

PROJECTED WESTBOUND NORTH WALL GEOLOGY

Designer: H. Hume	Structure Numbers		Project No./Code
Detailer: M. Walz			
Subset:	Subset Sheets: of		Sheet Number

Mike Walz 4:45:38 PM c:\pw_work\pbsjpw1\common\dms23370\I-70 WB Tunnel Mapping01.dgn

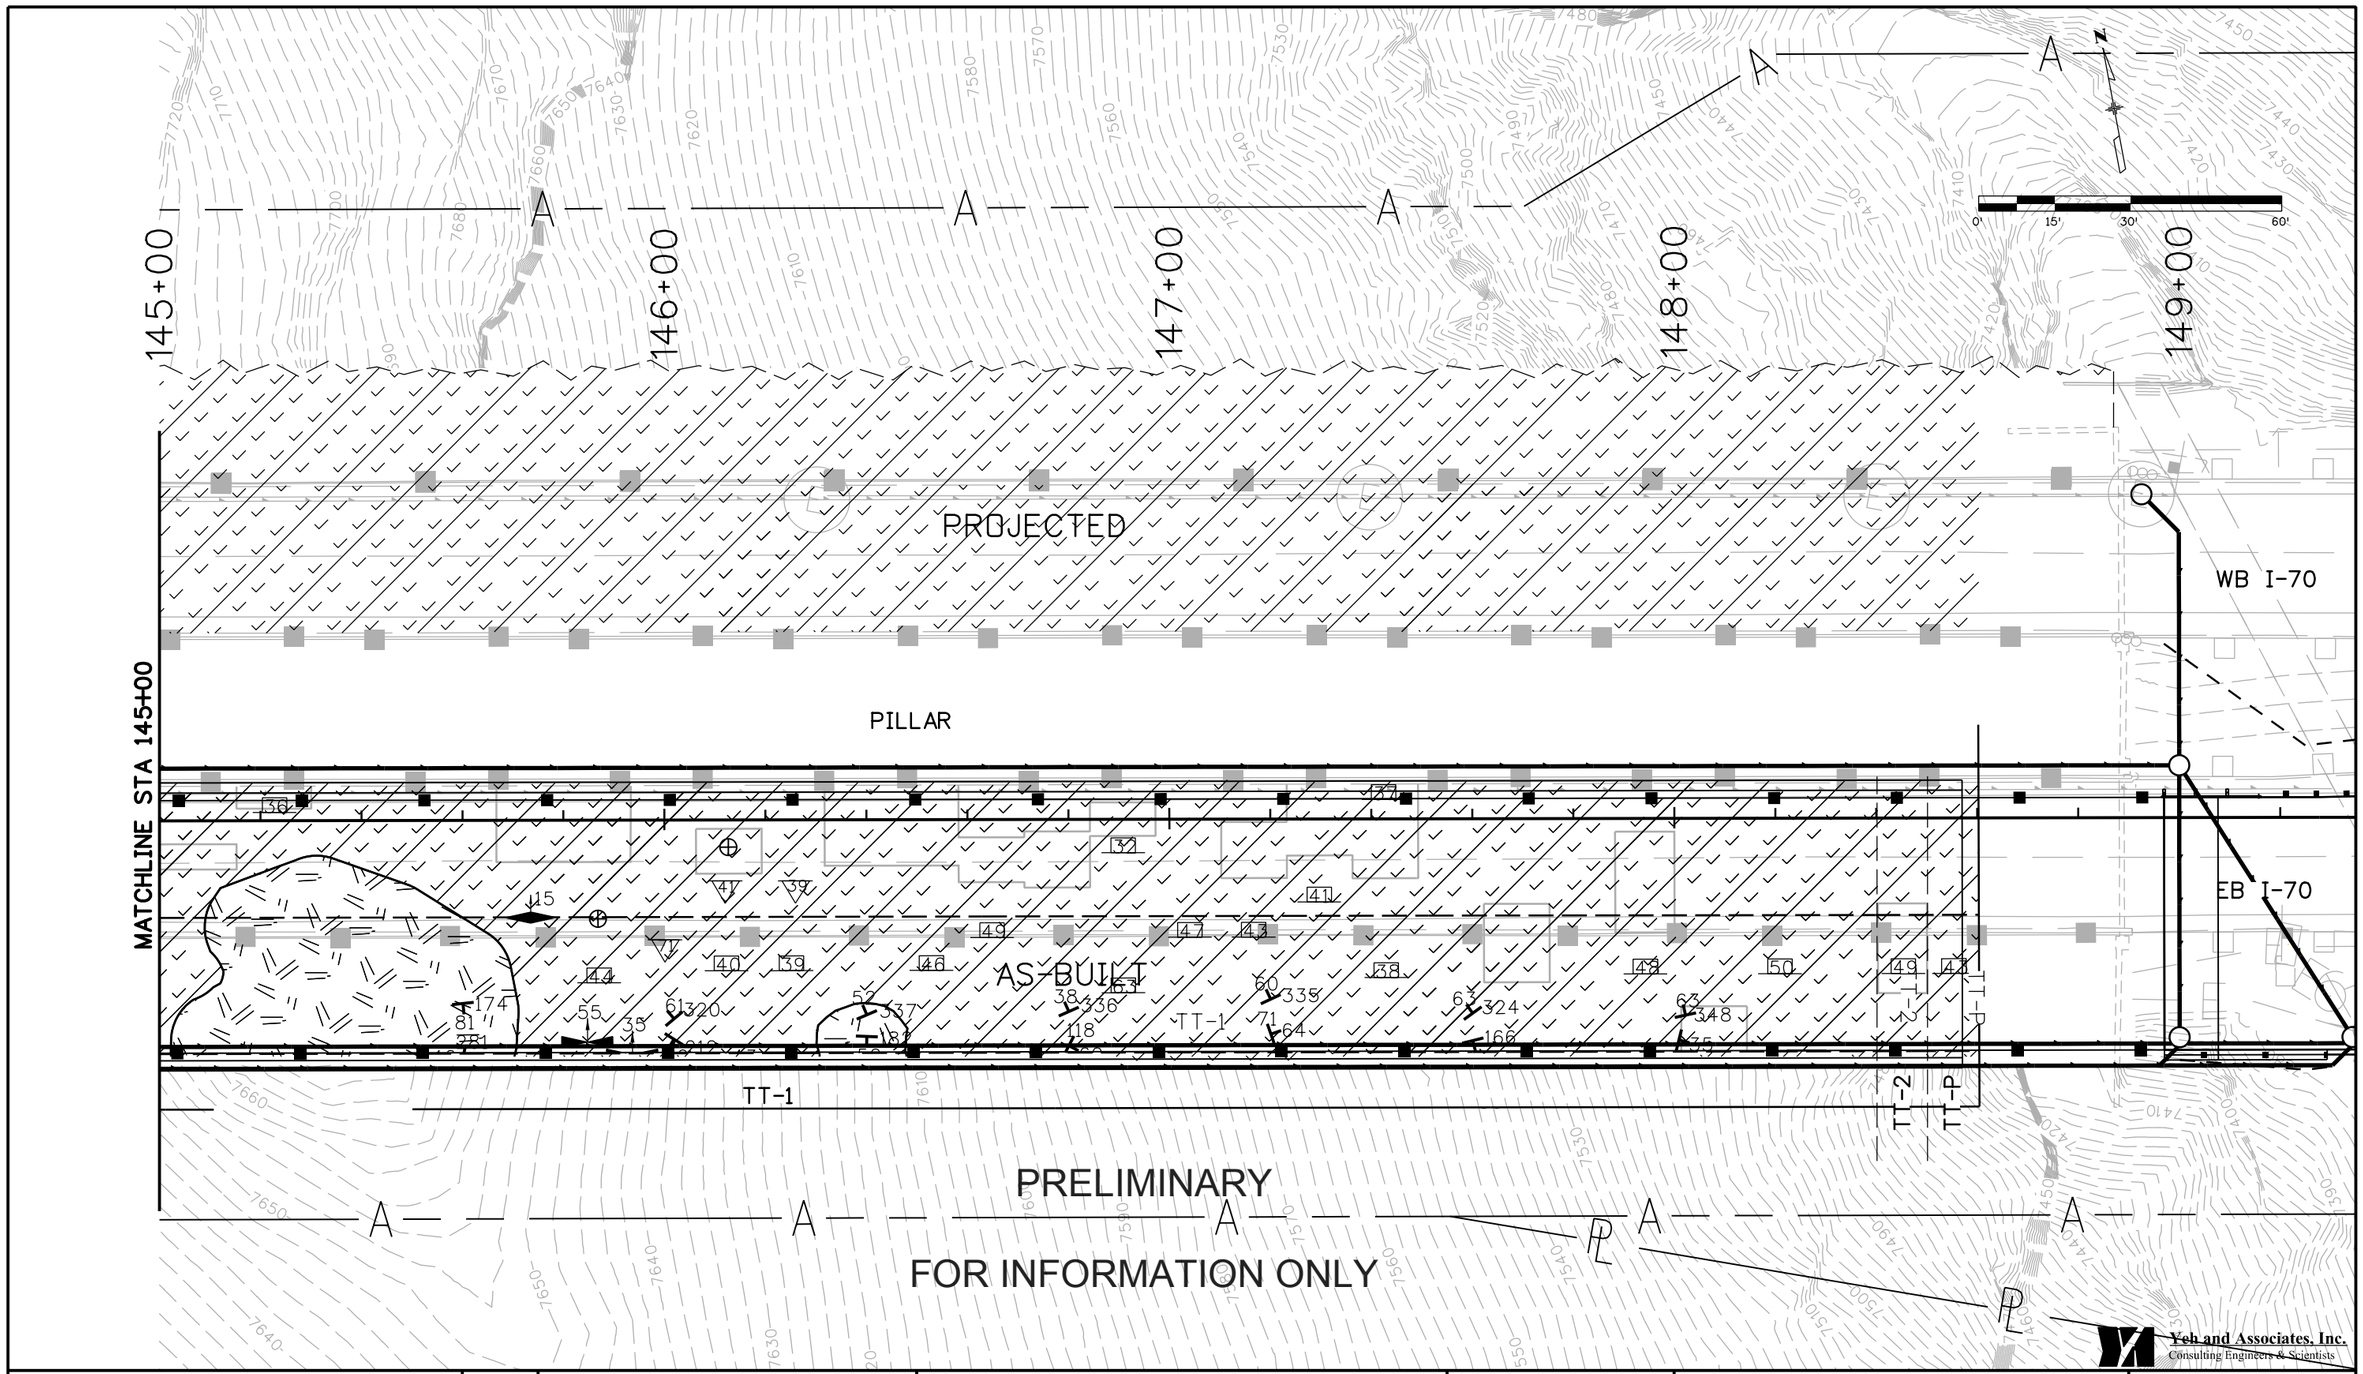

PRELIMINARY

FOR INFORMATION ONLY

Yeh and Associates, Inc.
Consulting Engineers & Scientists

Print Date: 11/8/2013
File Name: I-70 WB Tunnel Mapping02.dgn
Horiz. Scale: Vert. Scale:

ATKINS
4601 DTC Boulevard, Suite 700
Denver, CO 80237
Phone: (303) 221-7275 Fax: (303) 221-7276

Sheet Revisions		
Date:	Comments	Init.

Colorado Department of Transportation
DEPARTMENT OF TRANSPORTATION
425 A Corporate Circle
Golden, CO 80401
Phone: 720-497-6905 FAX: 720-497-6901
Region 1 CRC

As Constructed
No Revisions:
Revised:
Void:

PROJECTED WESTBOUND
NORTH WALL GEOLOGY

Designer: H. Hume
Detailer: M. Walz
Subset:
Structure Numbers
Subset Sheets: of

Project No./Code

Sheet Number

Mike Walz 4:55:49 PM c:\pw_work\pbsjpw1\common\dms23370\I-70 WB Tunnel Mapping02.dgn